$BOX \cap BL$

STUDIO CASITA TWO DOOR MODEL BXB-000009

| R | EVIS | ION | IS | | DRAWING INDEX | | | |
|----------|------------|------------|-----------|-----------------|--|--|--|--|
| 00-00-00 | 10-06-23 | 09-13-23 | 08-17-23 | Sheet Number | Sheet Title | | | |
| | 1 3 | $\sqrt{2}$ | | G1.0 | COVER SHEET | | | |
| | | | | G2.0 | ENERGY CALCS | | | |
| | | | | G2.1 | ENERGY CALCS | | | |
| | | | | ARCHITEC | TURAL | | | |
| | Μ | | Λ | A1.0 | FLOOR PLAN | | | |
| | | | | A2.0 | EXTERIOR ELEVATIONS | | | |
| | ⅓ | | | A3.0 | WALL SECTIONS | | | |
| | | | | MECHANI | CAL | | | |
| | | | | M1.0 | MECHANICAL NOTES, SYMBOLS, AND ABBREVIATIONS | | | |
| | | | Λ | M2.0 | MECHANICAL PLANS | | | |
| | | | | M3.0 | MECHANICAL DETAILS | | | |
| | | | | ELECTRIC. | AL | | | |
| | | | | E1.0 | SYMBOL LIST, GENERAL NOTES & SPECIFICATIONS | | | |
| | ⅓ | | | E2.0 | ELECTRICAL PLANS | | | |
| | | | | PLUMBIN | BING | | | |
| | $\sqrt{3}$ | | Λ | P1.0 | PLUMBING NOTES, SYMBOLS, AND ABBREVIATIONS | | | |
| | | $\sqrt{2}$ | Λ | P2.0 | PLUMBING PLANS | | | |
| | $\sqrt{3}$ | $\sqrt{2}$ | | P3.0 | PLUMBING DETAILS | | | |

TOTAL BUILDING AREA-361 SOFT BUILDING HEIGHT: CONSTRUCTION TYPE V-B (STRUCTURAL INSULATING PANELS ROOF LIVE LOAD: 20 PSF I = 1 Ss = 0.674 S1 = .222 ROOF SNOW LOAD: 29 PSE SITE CLASS = D (ASSUMED) ROOF DEAD LOAD: 6 PSF (+ 16 PSF Sos = 0.567 Sos = 0.325 MAX. IF ROOF TRUSS IS USED) SEISMIC DESIGN CATEGORY: D BASIC SEISMIC FORCE RESISTING SYSTEM FLOOR DEAD LOAD: 5 PSE = LIGHT FRAMED WALLS W/ SHEAR PANELS ULT, WIND SPEED: 115 MPH, EXPOSURE: C. OF MGO AND STEEL 127 MPH, EXPOSURE: B DESIGN BASE SHEAR =1.134 LB (ASD) R = 6.5 PER ICC-ESR REPORT ANALYSIS PROCEDURE: EQUIV. LATERAL FORCE NFPA 286 CORNER BURN TEST ASTM E84 NON-COMBUSTIBLE MATERIAL CONSTRUCTION ICC EVALUATION REPORT ESR 4725

BUILDING DATA

OCCUPANCY CLASSIFICATION

IRC ACCESSORY STRUCTURE OR DWELLING UNIT

ADDRESS:

1234 STREET CITY: COUNTY: COUNTY

STATE: ARIZONA

BUILDING CODE:

BUILDING CODE:

MECHANICAL CODE: FLECTRICAL CODE:

2018 INTERNATIONAL MECHANICAL CODE 2017 NATIONAL ELECTRICAL CODE 2018 INTERNATIONAL PLUMBING CODE PLUMBING CODE:

2018 INTERNATIONAL RESIDENTIAL CODE

BUILDING INFORMATION

2018 INTERNATIONAL ENERGY ENERGY CODE: CONSERVATION CODE FIRE PREVENTION CODE: 2018 INTERNATIONAL FIRE CODE

PROJECT CONTACTS

5345 EAST NORTH BELT ROAD LAS VEGAS, NV 89115

ARCHITECT SEVAN DESIGN SOLUTIONS P.C. 3025 HIGHLAND PARKWAY, SUITE 850 DOWNERS GROVE, ILLINOIS ELECTRICAL ENGINEER
DICKERSON ENGINEERING, INC 3343 NORTH RIDGE ARLINGTON HEIGHTS, IL 60004 DAVIS DICKERSON

MECHANICAL & PLUMBING ENGINEER WCW ENGINEERS, INC. 760 CREEL DRIVE WOOD DALE, IL 60191 630-595-8800 JOSEPH G. THOMAS

FIELD SCOPE OF WORK

- BOXABL UNITS ARE FABRICATED WITH A FLAT ROOF. IT IS THE RESPONSIBILITY OF THE OWNER/INSTALLER TO INSTALL A CODE APPROVED ROOF ON-SITE
- FOUNDATION SYSTEMS MAY BE REQUIRED BY YOUR LOCAL AHJ, SOME FOUNDATION DESIGNS ARE FOUND IN THIS PLAN SET, MORE CAN BE FOUND AT BOXABL COM/FOUNDATIONS. IT IS THE OWNER'S RESPONSIBILITY TO HAVE AN APPROPRIATE FOUNDATION BUILT FOR THE SITE CONDITIONS
- THE OWNER IS RESPONSIBLE FOR CONNECTING BOXABL UNITS TO LOCAL UTILITIES. UTILITY CONNECTION SIZES & LOCATIONS CAN BE FOUND ON THE MEP
- THE OWNER IS RESPONSIBLE FOR ERECTING THE BOXABL HINGED PANEL SYSTEM AND INTERLOCKING PANELS USING HARDWARE PROVIDED PER INSTALLATIO INSTRUCTIONS SPECIFIC TO THEIR MODEL
- FINAL SHOWER INSTALLATION ON-SITE MAY BE REQUIRED SUCH AS PANEL INSTALLATION OR CAULKING. SEE SPECIFIC UNIT OWNERS MANUAL FOR DETAILS
 THE OWNER IS RESPONSIBLE FOR THE INSTALLATION OF MISCELLANEOUS ITEMS WHICH MAY INCLUDE BUT ARE NOT LIMITED TO: THE BATHROOM MIRROR BATHROOM DOOR, EXTERIOR LIGHT SCONCES. INTERIOR PENDANT LIGHT, SMOKE DETECTOR, REFRIGERATOR, WASHER DRYER UNIT, OVER THE FRIDGE CABINETRY & HIDE PANELS AND THE BREAKFAST BAR COUNTERTOP.

GENERAL NOTES

THE ARCHITECT AND HIS CONSULTANTS DO NOT WARRANTY OR GUARANTEE THE COMPLETENESS OF THE WORK BEYOND A REASONABLE DILIGENCE. IF ANY ERRORS, DISCREPANCIES, OR OMISSIONS ARE FOUND TO EXIST IN THE WORK PRODUCT. THE ARCHITECT SHALL BE PROMPTLY NOTIFIED SO THAT HE MAY HAVE THE OPPORTUNITY TO TAKE WHATEVER STEPS NECESSARY TO RESOLVE THE ISSUE. FAILURE TO PROMPTLY NOTIFY THE ARCHITECT OF SUCH CONDITIONS, SHALL ABSOLVE THE ARCHITECT FROM ANY RESPONSIBILITY OF SUCH FAILURE, ACTION TAKEN WITHOUT THE KNOWLEDGE AND CONSENT OF THE ARCHITECT, IN CONTRADICTION TO THE WORK PRODUCT, OR THE RECOMMENDATIONS OF THE ARCHITECT SHALL BECOME THE RESPONSIBILITY OF THE PARTIES RESPONSIBLE FOR TAKING SUCH ACTION

THESE DRAWINGS WERE PREPARED BASED ON THE ASSUMPTION THAT ANY CONTRACTOR, SUBCONTRACTOR, SUPPLIER, OR VENDOR INVOLVED IN THE CONSTRUCTION OF THE WORK DESCRIBED HEREIN HAS EXPERIENCE IN THEIR RESPECTIVE AREAS OR DISCIPLINES THAT MAKE UP THE SCOPE OF THE PROJECT.

MANUFACTURERS COMPLIANCE CERTIFICATE CAN BE FOUND INSIDE THE ELECTRICAL SUB PANEL DOOR.

THESE UNITS ARE PREFABRICATED FACTORY BUILT BUILDINGS. PLUMBING, ELECTRICAL, & HVAC ARE PRE-INSTALLED, AND ARE CONNECTED TO INCOMING UTILITIES WHEN THE UNIT IS

FOUNDATION SYSTEM IS PERMITTED & INSTALLED SEPARATELY BY THE UNIT OWNER

DESCRIPTION:

1

9/13/23

10/6/23

PLAN REVIEW COMMENTS

OWNER CLARIFICATIONS

PLAN REVIEW REVISIONS

THIS SET IS INTENDED TO BE USED IN CONJUNCTION WITH THE MANUFACTURERS PANEL DRAWINGS AND STRUCTURAL DRAWINGS.

PROFESSIONAL SEAL

FACTORY SCOPE OF WORK

- ALL EXTERIOR AND INTERIOR WALLS, FLOORS AND ROOFS ARE PRE-BUILT IN THE FACTORY AND PRE-FINISHED. SOME TOUCH UP WORK MAY BE NECESSARY AT PANEL HINGE POINTS ON-SITE.
- ALL INTERIOR ELECTRICAL DEVICES ARE PRE-INSTALLED AND TESTED EXCEPT FOR SMOKE DETECTORS, INTERNAL PENDANT LIGHT AND EXTERIOR SCONCE WHICH ARE PROVIDED BUT FIELD INSTALLED.
- ALL INTERIOR PLUMBING WATER LINES & DRAINS ARE FACTORY INSTALLED APART FROM THE REFRIGERATOR WATER LINE CONNECTION AND WASHER-DRYER INSTALLATION.
- ALL APPLIANCES EXCEPT FOR THE REFRIGERATOR AND WASHER-DRYER UNIT ARE PRE-INSTALLED. REFRIGERATOR AND WASHER-DRYER UNIT ARE INCLUDED BUT SITE-INSTALLED.
- OTHER MISCELLANEOUS COMPONENTS PER "CUSTOMER INSTALL KIT" ARE INCLUDED BUT MUST BE FIELD INSTALLED. THESE MAY INCLUDE BUT NOT BE LIMITED TO:
- BREAKFAST BAR COUNTERTOP COMPONENTS
- WASHER DRYER CABINET BOX
- OVER THE REFRIGERATOR CABINET
- MISC. ACCENT LIGHTING

ARCH C

MT

6/9/2023

1:3

SMOKE DETECTORS

HEET FORMAT:

HEET SCALE:

FLEASE DATE:

INTERIOR AND EXTERIOR TRIM COMPONENTS

| MODEL: 2 DOOR CASITA | BOXABL INC. | |
|----------------------|--|---|
| (ARIZONA) | 5345 EAST NORTH BELT ROAD NORTH LAS VEGAS, NV 89115, USA | |
| MODEL #: BXB-000009 | +1(702) 500-9000 HELLO@BOXABL.COM | |
| SHEET:G1.0 | PROPRIETARY AND CONFIDENTIAL THE INFORMATION CONTAINED IN THIS DRAWING IS THE SOLE PROPERTY OF BOXABL INC. ANY REPRODUCTION IN PART OR AS A WHOLE WITHOUT THE WRITTEN PERMISSION OF BOXABL INC. IS PROHIBITED. | В |



Energy Code: Pima County, Arizona Construction Type: Single-family Project Type New Construction Orientation: Bldg. faces 180 deg. from North
Conditioned Floor Area: 324 ft2

Glazing Area 2 (1999 HDD)

Permit Date:

Permit Number:

Designer/Contractor

Slab-on-grade tradeoffs are no longer considered in the UA or performance compliance path in REScheck. Each slab-on-grade assembly in the specified climate zone must meet the minimum energy code insulation R-value and depth requirements.

Envelope Assemblies

| Assembly | Gross Area or Perimeter | Cavity R-Value | Cont. R-Value | Prop. U-Factor | Req. U-Factor | Prop. UA | Req. UA |
|---|-------------------------------|-------------------|------------------|-------------------|------------------|-------------|------------|
| Ceiling: Other | 324 | | | 0.042 | 0.030 | 14 | 1 |
| Left Wall: Other Orientation: Left side | 129 | | | 0.042 | 0.084 | 4 | |
| Rear Door: Solid Door (under 50% glazing) Orientation: Left side | 24 | | | 0.150 | 0.400 | 4 | 1 |
| Back Wall: Other Orientation: Back | 153 | | | 0.042 | 0.084 | 6 | 1 |
| 3x4 Window: Vinyl Frame SHGC: 0.23 Orientation: Back | 12 | | | 0.220 | 0.400 | 3 | |
| 2x3 Window: Vinyl Frame SHGC: 0.23 Orientation: Back | 6 | | | 0.220 | 0.400 | 1 | |
| Right Wall: Other Orientation: Right side | 147 | | | 0.042 | 0.084 | 4 | |
| Entry Door: Solid Door (under 50% glazing) Orientation: Right side | 24 | | | 0.150 | 0.400 | 4 | 1 |
| 3x6 Window C: Vinyl Frame SHGC: 0.21 Orientation: Right side | 18 | | | 0.250 | 0.400 | 5 | |
| Front Wall: Other Orientation: Front | 135 | | | 0.042 | 0.084 | 4 | |
| 3x6 Window A: Vinyl Frame SHGC: 0.21 Orientation: Front | 18 | | | 0.250 | 0.400 | 5 | 7 |
| 3x6 Window B: Vinyl Frame SHGC: 0.21 Orientation: Front | 18 | | | 0.250 | 0.400 | 5 | , |
| Voids: Structural Insulated Panels | 16 | | 0.0 | 0.326 | 0.064 | 5 | 1 |
| Floor: Other | 308 | | | 0.042 | 0.064 | 13 | 20 |

Generated by REScheck-Web Software **Compliance Certificate**

Boxabl AZ (2-Door) Project

Energy Code: 2018 IECC Coconino County, Arizona Construction Type: Single-family Project Type: Orientation: Bldg. faces 180 deg. from North
Conditioned Floor Area: 324 ft2

Glazing Area Climate Zone: 5 (6999 HDD) Permit Date:

Permit Number

3

Designer/Contractor

| Envelope Assemblies | 1 | [*] ADI | DED 4" BI | OWN IN | CELLULO | SE INSUI | LATION |) |
|---|-------------------------------|-------------------|------------------|-------------------|---------|-------------|------------|---|
| Assembly | Gross Area or Perimeter | Cavity R-Value | Cont. R-Value | Prop. U-Factor | Req. | Prop. UA | Req. UA | |
| Ceiling: Other | 324 | | | 0.026 | 0.026 | 8 | 8 | |
| Left Wall: Other Orientation: Left side | 129 | | | 0.042 | 0.060 | 4 | 6 | |
| Rear Door: Solid Door (under 50% glazing) Orientation: Left side | 24 | | | 0.150 | 0.300 | 4 | 7 | |
| Back Wall: Other Orientation: Back | 153 | | | 0.042 | 0.060 | 6 | 8 | |
| x4 Window: Vinyl Frame SHGC: 0.23 Orientation: Back | 12 | | | 0.220 | 0.300 | 3 | 4 | |
| 2x3 Window: Vinyl Frame SHGC: 0.23 Orientation: Back | 6 | | | 0.220 | 0.300 | 1 | 2 | |
| Right Wall: Other Orientation: Right side | 147 | | | 0.042 | 0.060 | 4 | 6 | |
| Entry Door: Solid Door (under 50% glazing) Orientation: Right side | 24 | | | 0.150 | 0.300 | 4 | 7 | |
| 3x6 Window C: Vinyl Frame SHGC: 0.21 Orientation: Right side | 18 | | | 0.250 | 0.300 | 5 | 5 | |
| Front Wall: Other Orientation: Front | 135 | | | 0.042 | 0.060 | 4 | 6 | |
| 3x6 Window A: Vinyl Frame SHGC: 0.21 Orientation: Front | 18 | | | 0.250 | 0.300 | 5 | 5 | |
| 3x6 Window B: Vinyl Frame SHGC: 0.21 Orientation: Front | 18 | | | 0.250 | 0.300 | 5 | 5 | |

CALCULATIONS:

THESE VALUES WERE USED TO CREATE THE RESCHECK COMPLIANCE CERTIFICATE

WALL ASSEMBLY

OUTSIDE AIR FILM: 0.25

5.75" EPS WALL PANEL: 22.54 (ASSUMES R VALUE OF 3.92/INCH) VARIES ANYWHERE FROM 3.5 TO 4.0

1/4" MGO BOARD: 0 INSIDE AIR FILM: 0.68

TOTAL FOR WALL ASSEMBLY: R= 23.47 U= 0.0426

FLOOR ASSEMBLY

OUTSIDE AIR FILM: 0.92

6.75" EPS WALL PANEL: 26.46 (ASSUMES R VALUE OF 3.92/INCH) VARIES ANYWHERE FROM 3.5 TO 4.0

1/4" MGO BOARD: 0 INSIDE AIR FILM: 0.92

TOTAL FOR FLOOR ASSEMBLY: R= 28.3 U= 0.0354

ROOF ASSEMBLY

OUTSIDE AIR FILM: 0.61

6.75" EPS WALL PANEL: 26.46 (ASSUMES R VALUE OF 3.92/INCH)

VARIES ANYWHERE FROM 3.5 TO 4.0

1/4" MGO BOARD: 0 INSIDE AIR FILM: 0.61

TOTAL FOR ROOF ASSEMBLY: R= 27.68 U= 0.0362

NOTES:

- CLIMATE ZONE 5: ADD 4" BLOWN IN CELLULOSE INSULATION (R = 14.4) OR OTHER INSULATION OF EQUAL R VALUE
- ENVELOPE CALCULATIONS WERE DONE USING THE PERFORMANCE METHOD
- BASED ON OUR RESCHECK ANALYSIS, THE LOSS OF THERMAL EFFICIENCY DUE TO INTERNAL CHASES, AND OTHER VOIDS WERE NEGLIGIBLE, AND DID NOT HAVE A NEGATIVE EFFECT ON THE OVERALL THERMAL PERFORMANCE OF THE UNIT.
- R VALUES NOTED ABOVE (R 3.92/IN) ARE REFERENCED IN ICC EVALUATION REPORT ESR 1962, FOR EXPANDED POLYSTYRENE INSULATION. THIS INSULATION IS LISTED AS THE INSULATION USED IN THE IN ICC ES EVALUATION REPORT ESR 4725 FOR STRUCTURAL INSULATION PANELS.

| DATE: | REV: | DESCRIPTION: | PROFESSIONAL SEAL |
|---------|------|-----------------------|-------------------|
| 8/17/23 | 1 | PLAN REVIEW COMMENTS | |
| 9/13/23 | 2 | OWNER CLARIFICATIONS | |
| 10/6/23 | 3 | PLAN REVIEW REVISIONS | |
| | | | |
| | | | |

SHEET SCALE: 1:3 CREATED BY: MT RELEASE DATE: 6/9/2023

SHEET FORMAT:

0.326 0.033

0.042 0.033

MODEL: 2 DOOR CASITA (ARIZONA) BOXABL INC.

5345 EAST NORTH BELT ROAD NORTH LAS VEGAS, NV 89115, USA

MODEL #: BXB-000009

SHEET:G2.0

1(702) 500-9000 HELLO@BOXABL.COM PROPRIETARY AND CONFIDENTIAL THE INFORMATION CONTAINED IN THIS DRAWING IS THE SOLE PROPERTY OF BOXABLEING ANY REPRODUCTION IN BOXABL OF BOXABL INC. IS PROHIBITED.

2

ARCH C

REScheck Software Version : REScheck-Web

Inspection Checklist
Energy Code: 2018 IECC
Requirements: 0.0% were addressed directly in the REScheck software
Text in the "CommentsAssumptions" column is provided by the user in the REScheck Requirements screen. For each requirement, the user certifies that a code requirement will be met and how that is documented, or that an exception to being clialmed, Where compliance is bettied that a perspective bulk, or reference to that table is provided.

| Section # & Req.ID | Pre-Inspection/Plan Review | Plans Verified Value | Field Verified Value | Complies? | Comments/Assumptions |
|---|--|--|--|---|----------------------|
| 103.1, 103.2 [PR1] ¹ | Construction drawings and documentation demonstrate energy code compliance for the building envelope. Thermal envelope represented on construction documents. | | | □Complies □Does Not □Not Observable □Not Applicable | |
| 103.1, 103.2, 403.7 [PR3] ¹ | Construction drawings and documentation demonstrate energy code compliance for lighting and mechanical systems. Systems serving multiple dwelling units must demonstrate compliance with the IECC Commercial Provisions. | | | Complies Does Not Not Observable Not Applicable | |
| 302.1, 403.7 (PR2) ² | Heating and cooling equipment is sized per ACCA Manual S based on loads calculated per ACCA Manual J or other methods approved by the code official. | Heating: Btu/hr Cooling: Btu/hr | Heating: Btu/hr Cooling: Btu/hr | □Complies □Does Not □Not Observable □Not Applicable | |

| Section # & Req.ID | Foundation Inspection | Complies? | Comments/Assumptions |
|--------------------------------|---|---|----------------------|
| 303.2.1 (FO11) ² | protect exposed exterior insulation and extends a minimum of 6 in. below | □Complies □Does Not □Not Observable □Not Applicable | |
| 403.9 [FO12] ² | Snow- and ice-melting system controls installed. | □Complies □Does Not □Not Observable □Not Applicable | |

| Section # & Reg.ID | Final Inspection Provisions | Plans Verified Value | Field Verified Value | Complies? | Comments/Assumptions |
|---|--|-------------------------|-------------------------|---|---|
| & Req.ID 402.1.1, 402.2.1, 402.2.2, 402.2.6 [FI1] ¹ | Ceiling insulation R-value. | R Wood Steel | R Wood Steel | □Complies □Does Not □Not Observable □Not Applicable | See the Envelope Assemblies table for values. |
| 303.1.1.1, 303.2 [FI2] ¹ | Ceiling insulation installed per manufacturer's instructions. Blown insulation marked every 300 ft ² . | | | □Complies □Does Not □Not Observable □Not Applicable | |
| 402.2.3 [FI22] ² | Vented attics with air permeable insulation include baffle adjacent to soffit and eave vents that extends over insulation. | | | □Complies □Does Not □Not Observable □Not Applicable | |
| 402.4.1.2 (FI17) ¹ | Blower door test @ 50 Pa. <=5 ach in Climate Zones 1-2, and <=3 ach in Climate Zones 3-8. | ACH 50 = | ACH 50 = | □Complies □Does Not □Not Observable □Not Applicable | |
| 403.3.3 [FI27] ¹ | Ducts are pressure tested to determine air leakage with eithers. Rough-in test: Total leakage must great pressure differential of 0.1 inch way, across the system Including enclosure if installed at time of test. Postconstruction test: Total leakage measured with a pressure differential of 0.1 inch pressure diff | cfm/100 | rt ² cfm/100 | □Compiles □Does Not □Not Observable □Not Applicable | |
| 403.3.4 [FI4] ¹ | Duct tightness test result of <=4 cfm/100 ft2 across the system or <=3 cfm/100 ft2 without air handler @ 25 Pa. For rough-in tests, verification may need to occur during Framing Inspection. | tt ² cfm/100 | cfm/100 | □Complies □Does Not □Not Observable □Not Applicable | |
| 403.3.2.1 [FI24] ¹ | Air handler leakage designated by manufacturer at <=2% of design air flow. | | | □Complies □Does Not □Not Observable □Not Applicable | |
| 403.1.1 [FI9] ² | Programmable thermostats installed for control of primary heating and cooling systems and initially set by manufacturer to code specifications. | | | □Complies □Does Not □Not Observable □Not Applicable | |
| 403.1.2 [FI10] ² | Heat pump thermostat installed on heat pumps. | | | □Complies □Does Not □Not Observable □Not Applicable | |
| 403.5.1 FI11] ² | Circulating service hot water systems have automatic or accessible manual controls. | | | □Complies □Does Not □Not Observable □Not Applicable | |
| 403.6.1 [FI25] ² | All mechanical ventilation system fans not part of tested and listed HVAC equipment meet efficacy and air flow limits per Table R403.6.1. | | | □Complies □Does Not □Not Observable □Not Applicable | |

PROFESSIONAL SEAL

DATE: REV: DESCRIPTION:

2

PLAN REVIEW COMMENTS

OWNER CLARIFICATIONS

PLAN REVIEW REVISIONS

8/17/23 1

9/13/23

10/6/23 3


| Section # & Reg.ID | Framing / Rough-In Inspection | Plans Verified Value | Field Verified Value | Complies? | Comments/Assumptions |
|---|---|-------------------------|-------------------------|---|---|
| 402.1.1, 402.3.4 [FR1] ¹ | Door U-factor. | U | U | □Complies □Does Not □Not Observable □Not Applicable | See the Envelope Assemblies table for values. |
| 402.1.1, 402.3.1, 402.3.3, 402.5 [FR2] ¹ | Glazing U-factor (area-weighted average). | U | U | □Complies □Does Not □Not Observable □Not Applicable | See the Envelope Assemblies table for values. |
| 303.1.3 [FR4] ¹ | U-factors of fenestration products are determined in accordance with the NFRC test procedure or taken from the default table. | | | □Complies □Does Not □Not Observable □Not Applicable | |
| 402.4.1.1 [FR23] ¹ | Air barrier and thermal barrier installed per manufacturer's instructions. | | | □Complies □Does Not □Not Observable □Not Applicable | |
| 402.4.3 [FR20] ¹ | Fenestration that is not site built is listed and labeled as meeting AAMA /NDMA/CSA 101/L.S.2/A440 or has infiltration rates per NFRC 400 that do not exceed code limits. | | | □Complies □Does Not □Not Observable □Not Applicable | |
| 402.4.5 [FR16] ² | IC-rated recessed lighting fixtures sealed at housing/interior finish and labeled to indicate ≤2.0 cfm leakage at 75 Pa. | | | □Complies □Does Not □Not Observable □Not Applicable | |
| 405.2 [FR25] ¹ | All ducts in unconditioned spaces or outside the building envelope are insulated to ≥R-6. | R | R | □Complies □Does Not □Not Observable □Not Applicable | |
| 403.3.5 (FR15) ³ | Building cavities are not used as ducts or plenums. | | | □Complies □Does Not □Not Observable □Not Applicable | |
| 403.4 [FR17] ² | HVAC piping conveying fluids above 105 °F or chilled fluids below 55 °F are insulated to ≥R- 3. | R | R | □Complies □Does Not □Not Observable □Not Applicable | |
| 403.4.1 [FR24] ¹ | Protection of insulation on HVAC piping. | | | □Complies □Does Not □Not Observable □Not Applicable | |
| 403.6 [FR19] ² | Automatic or gravity dampers are installed on all outdoor air intakes and exhausts. | | | □Complies □Does Not □Not Observable □Not Applicable | |


| Section # Final Inspection Provision & Req.ID | | Plans Verified Value | Field Verified Value | Complies? | Comments/Assumptions |
|---|--|-------------------------|-------------------------|---|----------------------|
| 403.2 [FI26] ² | Hot water boilers supplying heat through one- or two-pipe heating systems have outdoor setback control to lower boiler water temperature based on outdoor temperature. | | | □Complies □Does Not □Not Observable □Not Applicable | |
| 403.5.1.1 [FI28] ² | Heated water circulation systems have a circulation pump. The system return pipe is a dedicated return pipe or a cold water supply pipe. Gravity and thermosyphon circulation systems are not present. Controls for includiting how water system circulating to water system for the state of the control of the c | | | □Complies □Does Not □Not Observable □Not Applicable | |
| 403.5.1.2 [FI29] ² | Electric heat trace systems comply with IEEE 515.1 or UL 515. Controls automatically adjust the energy input to the heat tracing to maintain the desired water temperature in the piping. | | | □Complies □Does Not □Not Observable □Not Applicable | |
| 403.5.2 [FI30] ² | Demand recirculation water systems have controls that manage operation of the pump and limit the temperature of the water entering the cold water piping to <= 1049F. | | | □Complies □Does Not □Not Observable □Not Applicable | |
| 403.5.4 [FI31] ² | Drain water heat recovery units tested in accordance with CSA B55.1. Potable water-side pressure loss of drain water heat recovery units < 3 psi for individual units connected to one or two showers. Potable water-side pressure loss of drain water heat recovery units < 2 psi for individual units connected to the two showers. We water water water water water water water heat recovery units < 2 psi for individual units connected to three or more showers. | | | Complies Does Not Not Observable Not Applicable | |
| 404.1 [FI6] ¹ | 90% or more of permanent fixtures have high efficacy lamps. | | | □Complies □Does Not □Not Observable □Not Applicable | |
| 404.1.1 (FI23) ³ | Fuel gas lighting systems have no continuous pilot light. | | | □Complies □Does Not □Not Observable □Not Applicable | |
| 401.3 [FI7] ² | Compliance certificate posted. | | | □Complies □Does Not □Not Observable □Not Applicable | |
| 303.3 [FI18] ³ | Manufacturer manuals for mechanical and water heating systems have been provided. | | | □Complies □Does Not □Not Observable □Not Applicable | |


| Section # & Req.ID | Insulation Inspection | Plans Verified Value | Field Verified Value | Complies? | Comments/Assumptions |
|--|--|----------------------------|-------------------------|---|--|
| 303.1 (IN13) ² | All installed insulation is labeled or the installed R-values provided. | | | □Complies □Does Not □Not Observable □Not Applicable | |
| 402.1.1, 402.2.6 [IN1] ¹ | Floor insulation R-value. | R Wood Steel | R Wood Steel | □Complies □Does Not □Not Observable □Not Applicable | See the Envelope Assemblles table for values. |
| 303.2, 402.2.8 [IN2] ² | Floor insulation installed per manufacturer's instructions and in substantial contact with the underside of the subloor, or floor framing cavity insulation is in framing cavity insulation is in substantial insulation is insulation is installed on the underside of floor framing and extends from the bottom to the top of all perimeter floor framing members. | | | □Complies □Does Not □Not Observable □Not Applicable | |
| 402.1.1, 402.2.5, 402.2.6 [IN3] ¹ ⊌ | Wall insulation R-value. If this is a mass wall with at least ½ of the wall insulation on the wall exterior, the exterior insulation requirement applies (FR10). | R Wood Mass Steel | RWood Mass Steel | Complies Does Not Not Observable Not Applicable | See the Envelope Assemblies table for values. |
| 303.2 [IN4] ¹ | Wall insulation is installed per manufacturer's instructions. | | | Complies Does Not Not Observable Not Applicable | |

| SHEET FORMAT: SHEET SCALE: | ARCH C 1:3 | MODEL: 2 DOOR CASITA | BOXABL INC. |
|-------------------------------|----------------|----------------------|--|
| CREATED BY: RELEASE DATE: | MT 6/9/2023 | (ARIZONA) | 5345 EAST NORTH BELT ROAD NORTH LAS VEGAS. NV 89115. USA |
| RELEASE DATE. | 0/3/2023 | MODEL #: BXB-000009 | +1(702) 500-9000 HELLO@BOXABL.COM |
| | | SHEET:G2.1 | PROPRIETARY AND CONFIDENTIAL THE INFORMATION CONTAINED IN THIS DRAWING IS THE SOLE PROPERTY OF BOXABL INC. ANY REPRODUCTION IN PART OR AS A WHOLE WITHOUT THE WRITTEN PERMISSION OF BOXABL INC. IS PROHIBITED. |



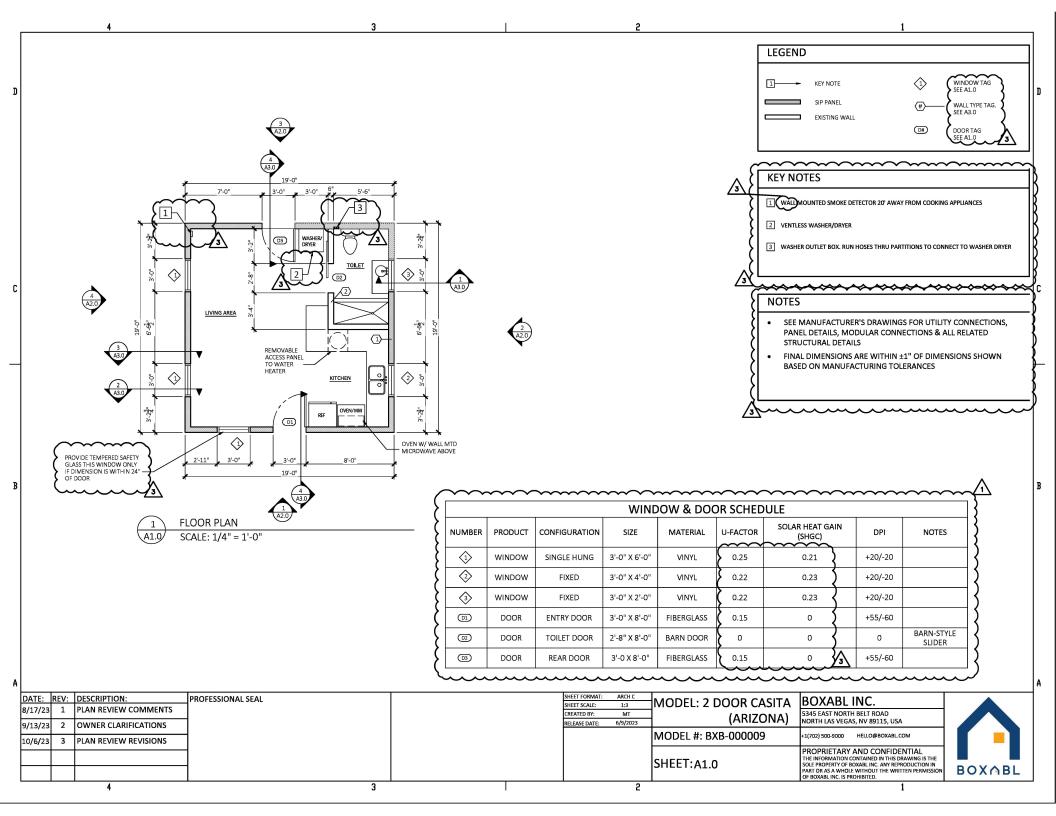

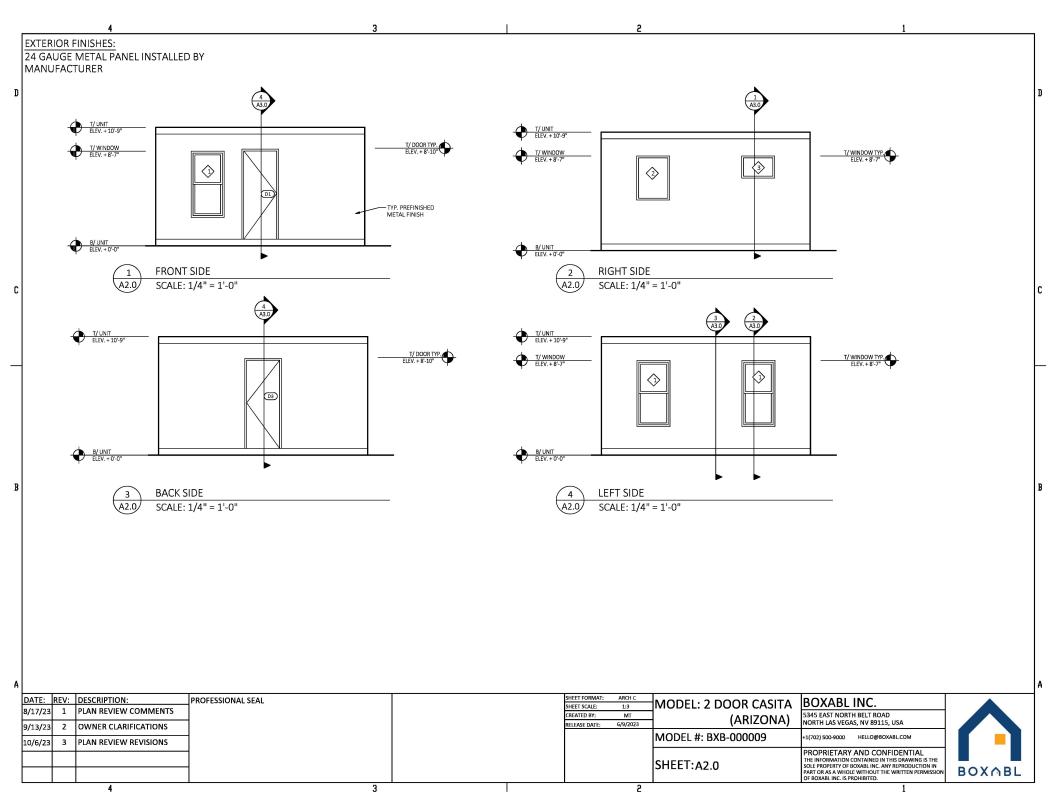

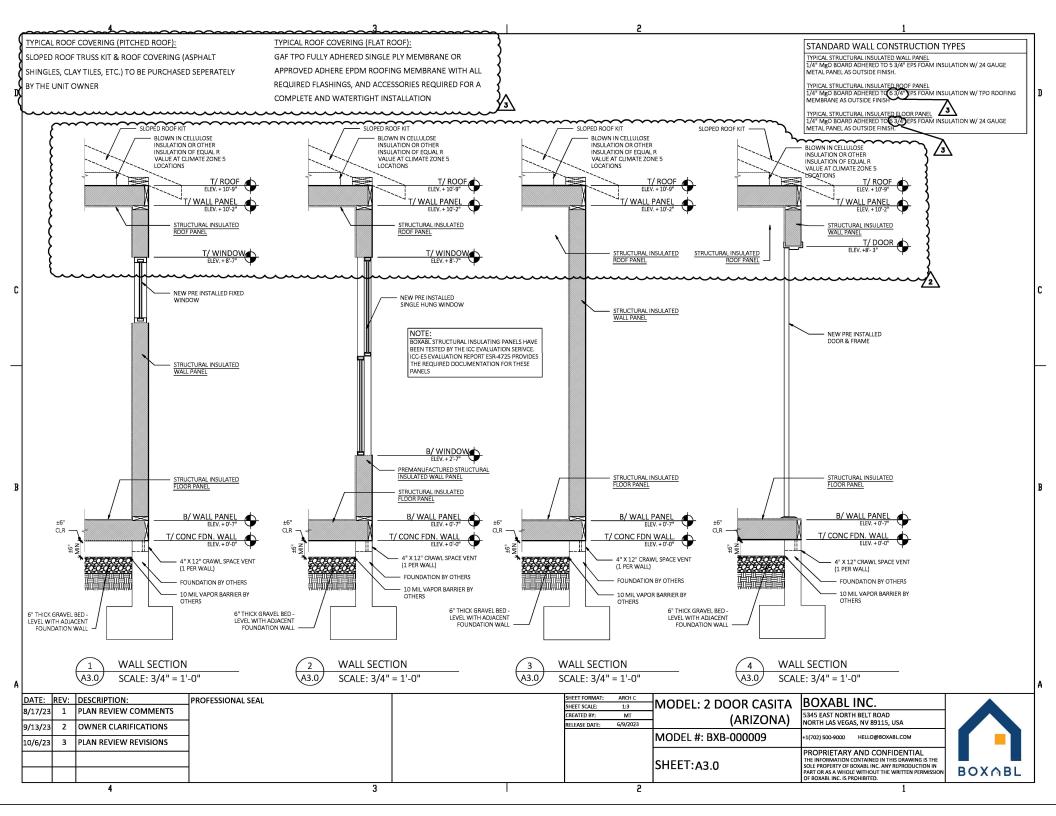

- 1. MECHANICAL SYSTEMS SHALL BE INSTALL IN ACCORDANCE WITH ALL APPLICABLE BUILDING
- 2. DRAWINGS FOR MECHANICAL WORK ARE DIAGRAMMATIC, SHOWING THE GENERAL LOCATION, TYPE, LAYOUT AND EQUIPMENT REQUIRED. THE DRAWINGS SHALL NOT BE SCALED FOR EXACT MEASUREMENTS. REFER TO MANUACTURERS STANDARD INSTALLATION D EQUIPMENT ON NETRIN S AND INSTALLATION REQUIREMENTS AS REQUIRED. FURNISH AND INSTALLATION REQUIREMENTS AS REQUIRED. FURNISH AND INSTALLA DUCTWORK, CONNECTIONS, ACCESSORIES, OFFSETS AND MATERIALS RECESSARY FACILITATE BY THE DESIGN AND THE EQUIPMENT INDICATED. THE WORK SHALL BE IN ACCORDANCE WITH LOCAL CODES AND ORDINANCES AND
- 3. THE MECHANICAL SYSTEMS SHALL BE COMPLETE WITH ALL NECESSARY APPURTENANCES FOR A
- 4. THE CONTRACTOR SHALL WARRANTEE ALL MATERIAL AND GUARANTEE ALL WORKMANSHIP FOR ONE YEAR FROM SUBSTANTIAL COMPLETION.

BASIC MATERIALS AND METHODS

1. MATERIALS SHALL REAR LINDERWRITERS LAREL WHERE SLICH STANDARDS HAVE REEN MAI EMALS SHALL BEAR UNDERWITE INS LABEL WHIER SUCH STANDARDS HAVE BEEN ESTABLISHED AND LISTED BY UNDERWITERS' LABORATORIES, INC. MATERIALS, EQUIPMENT AND APPLIANCES SHALL CONFORM TO THE LATEST STANDARDS OF: AMCA — AIR MOVING AND CONDITIONING ASSOCIATIONS, INC.

-SHEET METAL AND AIR CONDITIONING CONTRACTOR NATIONAL ASSOCIATION, INC. -AMERICAN SOCIETY OF HEATING, REFRIGERATION AND AIR ASHRAE CONDITIONING ENGINEERS -AMERICAN SOCIETY OF MECHANICAL ENGINFERS -AMERICAN SOCIETY FOR TESTING MATERIALS
-NATIONAL ELECTRICAL MANUFACTURER'S ASSOCIATION NEMA AIR CONDITIONING AND REFRIGERATION INSTITLITE ANSI AMERICAN NATIONAL STANDARDS INSTITUTE

COORDINATION

- COORDINATE WITH GENERAL CONTRACTOR FOR ALLOWABLE DAYS OF WEEK AND TIMES OF DAY
 FOR SYSTEMS SHUT DOWNS AS REQUIRED FOR THE CONSTRUCTION WORK.
- 2. THE MECHANICAL CONTRACTOR SHALL COORDINATE DUCTWORK INSTALLATION WITH ARCHITECTS/OWNERS REPRESENTATIVE IN FIELD AND OTHER TRADES
- 3. THE MECHANICAL CONTRACTOR SHALL COORDINATE VOLTAGE OF ALL FOLIPMENT WITH ELECTRICAL PRIOR TO ORDERING EQUIPMENT.

INSTALLATION

- CORE-DRILL OR SAW-CUT FLOOR, WALL, ROOF, ETC. AS REQUIRED FOR PIPING OR DUCTWORK AND FIRE-STOP OPENING AROUND PIPE OR DUCTWORK. VERIFY LOCATION OF STRUCTURAL BEAMS, JOISTS, ETC. BEFORE DRILLING OR CUTTING. NOTIFY ARCHITECT OF ANY
- 2. WHEREVER FOUNDATION WALLS, OUTSIDE WALLS, ROOFS, ETC. ARE CUT FOR INSTALLATION OF SYSTEMS, THEY SHALL BE PATCHED TO MATCH EXISTING CONSTRUCTION AND SEALED WEATHER-TIGHT. WORK SHALL BE PERFORMED BY CRAFTSMEN SKILLED IN THEIR RESPECTIVE
- 3. ALL PIPING THAT IS EXPOSED TO VIEW SHALL BE ROUTED AS HIGH AS POSSIBLE AND TIGHT TO THE UNDERSIDE OF THE STRUCTURAL ABOVE
- ALL OUTSIDE AIR INTAKES SHALL BE A MINIMUM OF 10'-0" AWAY FROM EXHAUST DISCHARGE OPENINGS AND PLUMBING VENT STACKS.

- 1. THE MECHANICAL CONTRACTOR SHALL INSTALL MECHANICAL SYSTEMS AS SHOWN, NOTED AND SPECIFIED. EQUIPMENT MAY NOT BE SUBSTITUTED UNLESS WRITTEN APPROVAL BY THE ARCHITECT, ENGINEER OR OWNER'S REPRESENTATIVE IS OBTAINED. ANY CHANGES TO THE DUCTWORK LAYOUT WILL NECESSITATE SUBMISSION OF SHEET METAL SHOP DRAWINGS FOR ENGINEER'S REVIEW. ANY UNAUTHORIZED CHANGES WILL BE REMOVED AT CONTRACTOR'S EXPENSE, IF DEEMED NECESSARY BY ARCHITECT, ENGINEER, OR OWNER'S REPRESENTATIVE.
- 2. UPON SELECTION OF THE MECHANICAL APPLIANCES, SUBMIT THE MANUFACTURER'S INSTALLATION INSTRUCTIONS TO THE BUILDING DEPARTMENT, INCLUDING LISTING FOR OUTSIDE INSTALLATION WHERE APPLICABLE.

AIR DISTRIBUTION

- ALL DUCTWORK SHALL BE FABRICATED ACCORDING TO THE SMACNA LOW VELOCITY DUCT MANUAL, ASHRAE HANDBOOK ULIME "HVAC SYSTEMS AND EQUIPMENT", AND TYPICAL DUCTWORK DETAILS SHOWN IN THESE DRAWINGS. ALL ELBOWS SHALL HAVE PROPER RADIUS. SIZES SHOW ON PLAN ARE INSIDE FREE AREA.
- 2. ALL FLEXIBLE DUCTWORK SHALL FACTORY ASSEMBLED CLASS 1 AIR DUCT (UL 181) WITH FIBERGLASS INSULATION AND REINFORCED OUTER PROTECTIVE COVER/VAPOR BARRIER. FLEX DUCT SHALL MEET NFPA 90A WITH FLAME SPREAD UNDER 25, SMOKE DEVELOPED UNDER 50, AND SHALL BE RATED FOR 2" W.C. PRESSURE AND 0 TO 250 DEGREE TEMPERATURE. MAXIMUM STRETCHED OUT LENGTH SHALL BE AS PER CODES.
- 3. PROVIDE UL APPROVED FIRE DAMPERS FOR ALL PENETRATIONS THROUGH FIRE RATED WALLS, PARTITIONS, CELLINGS, AND FLOORS. INSTALL FIRE DAMPERS AS PER MANUFACTURER'S DIRECTIONS AND PER UL GUIDELINES. PROVIDE ACCESS AS REQUIRED FOR SERVICING OF FIRE
- 4. ALL CONTRACTOR FABRICATED AND MANUFACTURER FABRICATED COMPONENTS OF THE OUTSIDE AIR, SUPPLY AIR, RETURN AIR AND EXHAUST SYSTEMS SHALL BE CONSTRUCTED AND INSTALLED AIR-TIGHT. THE INSTALLED SYSTEMS SHALL BE PRESSURE TESTED AS SPECIFIED. PIPE

OPENINGS IN SYSTEM COMPONENTS SHALL HAVE SHEET METAL BAFFLES, SET IN SEALANT, TO

AUTOMATIC TEMPERATURE CONTROLS

 CONTRACTOR SHALL FURNISH AND INSTALL ALL CONTROL WIRING AS REQUIRED.
 THERMOSTATS SHALL BE AS SPECIFIED OR AS FURNISHED WITH THE EQUIPMENT. PROVIDE TRANSFORMERS AS REQUIRED.

TESTING AND BALANCING

- 1. BALANCING CONTRACTOR SHALL BALANCE SYSTEMS TO AIR QUANTITIES SHOWN ON PLAN BALANCING CONTRACTOR SHALL BALANCE STSTEMS TO AIR QUANTITIES SHOWN ON PLAIN.

 BALANCING CONTRACTOR SHALL USE DUCT MOUNTED MANUAL DAMPERS FOR AIR SYSTEM

 BALANCING. USE OF A TERMINAL DAMPER IS NOT ACCEPTABLE.
- 2. TESTING AND BALANCING CONTRACTOR SHALL TEST ALL HVAC EQUIPMENT TO ENSURE PROPER OPERATION, TEST ALL CONTROLS TO ENSURE PROPER OPERATION, CALIBRATION AND ADJUSTMENT OF CONTROLS, AND TEST ECONOMIZERS TO ENSURE PROPER OPERATION
- 3. THE ARCHITECT AND/OR OWNER'S REPRESENTATIVE SHALL BE NOTIFIED 48 HOURS OR MORE PRIOR TO FINAL TESTING AND BALANCING WORK SO THAT THEY AND/OR THE ENGINEER MAY BE PRESENT TO OBSERVE THIS WORK. THE BALANCING CONTRACTOR SHALL SUBMIT WRITTEN REPORTS OF ALL AIR FLOW READINGS. STATIC PRESSURES. GPM RATES. PRESSURE READINGS. REPORTS OF ALL AIR FLOW READINGS, STATIL PRESSURES, SEMY RALES, PRESSURE READINGS. TEMPERATURE READINGS, MOTOR AMPERAGE, ETC., TO DOCUMENT PROPERTY OFERATING AND BALANCED MECHANICAL SYSTEMS IN ALL AREAS. A COPY OF THE TEST AND BALANCE REPORT SHALL BE SUBMITTED TO THE AUTHORITIES HAWING JURISDICTION PRIOR TO FINAL INSPECTION AND REQUESTING OCCUPANCY

CLOSEOUT DOCUMENTATION

- THE CONTRACTOR SHALL FURNISH TO THE BUILDING OWNER WITHIN 90
 RECEIPT OF THE CERTIFICATE OF OCCUPANCY THE
 A. OPERATING AND MAINTENANCE MANUAL. MANUAL SHALL CONSIST OF MANUFACTURER'S
- RECOMMENDATIONS, PROGRAMMING PROCEDURES AND DATA PIONTS, NARRATIVE AND OTHER MEANS OF ILLUSTRATING TO THE OWNER HOW THE BUDGES, CQUIPMENT AND SYSTEMS ARE INTENDED TO BE INSTALLED, MAINTAINED AND OPERATED.
- AS-BUILT HVAC DRAWINGS
- BALANCE REPORT OF HVAC SYSTEMS.

MECHANICAL ABBREVIATIONS

D


ACCESS DOOR ABOVE FINISHED FLOOR AIR COOLED CONDENSING UNIT A.D. A.F.F. ACCU CC CV EF F.C.U N.T.S. S.C.D. S.S. COOLING COIL CONTROL VALVE EXHAUST AIR FAN FAN COIL UNIT NOT TO SCALE SEE CONSTRUCTION DRAWINGS STAINLESS STEEL THERMOSTAT Ü.N.O. UNLESS NOTED OTHERWISE ARCHITECT OR ARCHITECTURAL BUILDING BLD'G BOT. CL'G. воттом CELLING CONC. DET. DN. CONCRETE DETAIL DOWN DRAWING

DWG. E.A.T. GA. ENTERING AIR TEMPERATURE GAUGE HEATING AND AIR CONDITIONING LEAVING AIR TEMPERATURE MOUNTED

SATURATED SUCTION TEMPERATURE S.S.T. T.S.P. TOTAL STATIC PRESSURE

DIAMETER/ROUND ELEVATION FROM FINISH FLOOR

| IV. | IECHANICAL SYMBOLS |
|---|---|
| H—⊕ DEVICE | THERMOSTAT WITH DEVICE CONTROLLED. |
| —ср— | CONDENSATE DRAINAGE PIPING |
| —ı— | REFRIGERANT LIQUID PIPING |
| —-s— | REFRIGERANT SUCTION PIPING |
| $-\!$ | LINE SIZE GATE VALVE |
| —Ф— | LINE SIZE BALL VALVE (2" & SMALLER) OR LINE SIZE BUTTERFLY VALVE (2-1/2" & LARGER) |
| ø | LINE SIZE BALANCING VALVE |
| _N | LINE SIZE CHECK VALVE |
| | LINE SIZE UNION |

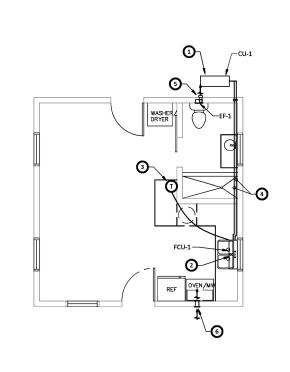

PLAN NOTES

1 NEW CONDENSING UNIT, CU-1. PROVIDE CONCRETE PAD TO HAVE THE CONDENSING UNIT ON A LEVEL SURFACE. COORDINATE EXACT LOCATION WITH ARCHITECT AND BUILDING OWNER.

ם

2 CONNECT CONDENSATE DRAIN FROM FCU-1 TO DRAIN LINE BELOW KITCHEN SINK.

3 THERMOSTAT (PROVIDED WITH UNIT).

REFRIGERANT PIPING TO BE RUN ON INSIDE FACE OF WALL PANELS. PIPING WILL BE HIDDEN FROM VIEW WITH REMOVABLE COVER PIECES.

5 PROVIDE HOODED WALL CAP.

6 INTAKE FOR WHOLE HOUSE VENTILATION SYSTEM. VENT-US MODEL PS-101.

WHOLE HOUSE VENTILATION SYSTEM SHALL BE COMPRISED OF TOILET EXHAUST FAN, 70 CFM AND INTAKE LOVER. VENTILATION RATE OF 20 CFM IS BASED ON EQUATION 15-1 USING 361 SQUARE FEET AND ONE BEDROOM. PER THESE CAPACITIES THE TOILET EXHAUST FAN WILL OPERATE 29% OF EACH 4 HOUR SEGMENT.

1 MECHANICAL PLAN

| | _ | | PROFESSIONAL SEAL | SHEET FORMAT: SHEET SCALE: | ARCH C | MODEL: 2 DOOR CASITA | BOXABL INC. | |
|---------|---|-----------------------|-------------------|-------------------------------|----------|----------------------|--|--------|
| 8/17/23 | 1 | PLAN REVIEW COMMENTS | | CREATED BY: | MT | (A DIZONA) | 5345 EAST NORTH BELT ROAD | |
| 9/13/23 | 2 | OWNER CLARIFICATIONS | | RELEASE DATE: | 6/9/2023 | , , | NORTH LAS VEGAS, NV 89115, USA | |
| 10/6/23 | 3 | PLAN REVIEW REVISIONS | 1 | | | MODEL #: BXB-000009 | +1(702) 500-9000 HELLO@BOXABL.COM | |
| | | | | | | | PROPRIETARY AND CONFIDENTIAL THE INFORMATION CONTAINED IN THIS DRAWING IS THE SOLE PROPERTY OF BOXABL INC. ANY REPRODUCTION IN | |
| | | | | | | | PART OR AS A WHOLE WITHOUT THE WRITTEN PERMISSION OF BOXABL INC. IS PROHIBITED. | BOXABL |

| | FAN COIL UNIT SCHEDULE | | | | | | | | | | | | | | | | | | | |
|--------------------------------|--|------------|-------------------|-----------------------|-----------------------|-------------------------------|-------------|-----------------------|----------------|----------------|-----------------------------|---------|--------------|-----|------|------------|---------------------|------|-------|---------|
| AIR COOLING HEATING ELECTRICAL | | | | | | | | | | | | | | | | | | | | |
| DESIG'N. | MFG'R. | MODEL NO. | QUANTITY (CFM) | E.A.T. DB *F/WB *F | L.A.T. DB *F/WB *F | TOTAL CAPACITY (BTU/HR) | REFRIGERANT | REFRIGERANT CHARGE | E.A.T. (*F) | L.A.T. (°F) | TOTAL CAPACITY @ 47°F | VOLTAGE | PHASE (Ø) | MCA | МОСР | COMPRESSOR | TYPE OF MOUNTING | HSPF | SEER | REMARKS |
| CU-1 | MITSUBISHI | MUZ-WR12NA | | | | | | | | | | 230 | 1 | 10 | 15 | ROTORY | ON GRADE | | | |
| CO-1 | LG | LSU120HFV3 | | | | | | | | | | 230 | 1 | 10 | 15 | INVERTER | ON GRADE | | | |
| FCU-1 | MITSUBISHI | MSZ-WR12NA | 400 | 75.0/62.3 | 55.0/53.4 | 12,000 | R410A | 1 LB 12 OZ | 60.0 | 88.2 | 12,200 | | | | | | WALL HUNG | 8.50 | 16.00 | |
| FC0-1 | LG | LSN120HFV3 | 459 | 75.0/62.3 | 33.0/33.4 | 12,000 | N41UA | 1181202 | 60.0 | 00.2 | 12,200 | | | | | | WALL HUNG | 9.00 | 17.00 | |
| IOTE: UNITS T | E: UNITS TO BE MANUFACTURER BY MITSUBISHI, I.G OR AN APPROVED EQUIVALENT UNIT. | | | | | | | | | | | | | | | | | | | |

| | EXHAUST FAN SCHEDULE | | | | | | | | | | | | |
|-------------|---|---------|-----------|------|-----|--------------------|--------|-----------------|--------------|---------|---------------------|-----------------|---------|
| DESIG'N | SERVICE | MFG'R | MODEL NO. | ТҮРЕ | CFM | STATIC PRESSURE | DRIVE | | ELECTRICAL | | BACKDRAFT DAMPER | OPER. WEIGHT | REMARKS |
| | | | | | | ("W.C.) | | H.P. (WATTS) | PHASE (Ø) | VOLTAGE | DAMIN EN | (LBS.) | |
| EF-1 | RESTROOM | ADDVENT | ABF 70 | WALL | 70 | 0.250 | DIRECT | (60) | | 115 | GRAVITY | 8 | |
| EF-1 | RESTROOM | DELTA | SLM 70 | WALL | 70 | 0.250 | DIRECT | (11.5) | 1 | 113 | GRAVIII | • | |
| NOTE: UNIT: | NOTE: UNITS TO BE MANUFACTURED BY ADDVENT, DELTA, OR AN APPROVED EQUIVALENT UNIT. | | | | | | | | | | | | |

MUZ-WR09NA MUZ-WR12NA

Refrigerant pipe a3/8 (e9.52)

With heat insulator)

With heat insulator)

With heat insulator)

A-way valve

With heat insulator

A-way valve

A-way valve

With heat insulator

A-way valve

A-way valve

With heat insulator

A-way valve

A-way

REFRIGERATION PIPING SYSTEM SCHEMATIC DETAIL NOT TO SCALE

| DATE: 8/17/23 | DESCRIPTION: PLAN REVIEW COMMENTS | PROFESSIONAL SEAL | SHEET | ET FORMAT: ET SCALE: | | 111000000000000000000000000000000000000 | BOXABL INC. |
|------------------|-----------------------------------|-------------------|-------|-------------------------|----------------|---|---|
| 9/13/23 | OWNER CLARIFICATIONS | | | ATED BY: EASE DATE: | MT 6/9/2023 | | 5345 EAST NORTH BELT ROAD NORTH LAS VEGAS, NV 89115, USA |
| 10/6/23 | PLAN REVIEW REVISIONS | 1 | | | | MODEL #: BXB-000009 | +1(702) 500-9000 HELLO@BOXABL.COM |
| | | | | | | SHEET: M3.0 | PROPRIETARY AND CONFIDENTIAL THE INFORMATION CONTAINED IN THIS DRAWING IS THE SOLE PROPERTY OF BOXABLINC. ANY REPRODUCTION IN PART OR AS A WHOLE WITHOUT THE WRITTEN PERMISSION |
| | | | | | | | OF BOXABL INC. IS PROHIBITED. |

GENERAL

- ALL WORK SHALL BE IN ACCORDANCE WITH ALL AUTHORITIES HAVING JURSIDICTION AND SUBJECT TO INSPECTION.
- HOOK-UP CHARGES, PERMITS AND ALL OTHER EXPENSES RELATED TO A COMPLETE AND FUNCTIONING PLUMBING SYSTEM ARE INCLUDED AS PART OF THE PLUMBING WORK.
- ALL AUTHORITIES HAVING JURISDICTION SHALL BE NOTIFIED AT LEAST THREE WORKING DAYS PRIOR TO COMMENCEMENT OF WORK.
- THE WORK INCLUDED PROVIDING THE PLUMBING SYSTEM AND PROVIDING NEW MATERIALS, FITTINGS AND ACCESSORIES NECESSARY FOR A COMPLETE FUNCTIONING PLUMBING SYSTEM.
- 5. THE INTENT OF THE DRAWMIGS IS TO INDICATE THE GENERAL EXTENT OF WORK REQUIRED FOR THE PROJECT. THE DRAWMIGS FOR PULWISHON WORK ARE DIAGRAMMATIC, SHOWMOTHE GENERAL LOCATION, TYPE, FIXTURE AND EQUIPMENT REQUIRED. THE DRAWMIGS SHALL NOT BE SCALED FOR EXACT MEASUREMENTS. REFER TO MANUFACTURERS STANDARD ROUGH-IN DRAWMIGS FOR PLUMBING EXTURES FOR EXACT LOCATIONS.

BASIC MATERIALS AND METHODS

MATERIALS SHALL BEAR UNDERWRITER LABEL WHERE SUCH STANDARDS
HAVE BEEN ESTABLISHED AND LISTED BY UNDERWRITER LABORATORIES, INC.
MATERIALS, EQUIPMENT AND APPLIANCES SHALL CONFORM TO THE LATEST
STANDARDS OF:

ANSI - AMERICAN NATIONAL STANDARDS INSTITUTE
ASHRAE - AMERICAN SOCIETY OF HEATING, REFRIGERATION AND AIR
CONDITIONING ENGINEERS

ASME -AMERICAN SOCIETY OF MECHANICAL ENGINEERS
ASTM -AMERICAN SOCIETY FOR TESTING ENGINEERS
NEMA NATIONAL ELECTRICAL MANUFACTURER'S ASSOCIATION

COORDINATION

- 1. COORDINATE WITH THE WORK OF OTHER TRADES.
- 2. REFER TO ARCHITECTURAL DRAWINGS OR CONSULT ARCHITECT FOR EXACT LOCATION OF FIXTURES, EQUIPMENT, ETC., AND FINAL FINISHED ELEVATIONS PRIOR TO ANY INSTALLATION WORK.
- 3. COORDINATE WITH GENERAL CONTRACTOR WHO SHALL CONSULT WITH THE OWNER FOR ALLOWABLE DAYS THAT WORK CAN BE PERFORMED AND TO SCHEDULE SYSTEM SHUT DOWNS AS REQUIRED FOR RELOCATION OF DISERS ETC.

INSTALLATION - GENERAL

- LISTED AND APPROVED THROUGH PENETRATION SYSTEM SHALL BE USED ON ALL PLUMBING PENETRATIONS OF FIRE RATED ASSEMBLIES.
- 2. EXPOSED PIPING IN FINISHED AREA SHALL BE WITH CHROME PLATED ESCUTCHEON AT PIPE ENTRY TO FINISHED AREA.
- ALL PIPING SHALL BE CONCEALED IN CABINETS AND FIXED FURNISHINGS UNLESS OTHERWISE INDICATED.
- CUT AND PATCH EXISTING FLOOR, WALL OR CEILING CONSTRUCTION AS REQUIRED FOR THE INSTALLATION WORK.
- SLEEVE OR CORE-DRILL FLOOR SLABS, WALLS, ETC. AS REQUIRED FOR PIPING AND FIRE STOP OPENING AROUND PIPE. VERIFY LOCATION OF STRUCTURAL BEAMS, JOIST, ETC. BEFORE DRILLING.
- WHEREVER FOUNDATION WALLS, OUTSIDE WALLS, ROOF, ETC. ARE PENETRATED FOR INSTALLATION OF SYSTEMS, THEY SHALL BE PATCHED TO MATCH EXISTING CONSTRUCTION AND SEALED WEATHER TIGHT. WORK SHALL BE PERFORMED BY CRAFTSMAN SKILLED IN THEIR RESPECTIVE
- 7. ALL PIPING SHALL BE RUN PARALLEL TO BUILDING LINES AND SUPPORTED AND ANCHORED AS REQUIRED TO FACILITATE EXPANSION AND CONTRACTION. ALL PIPING SHALL BE CONCEALED EXCEPT IN UNFINISHED SPACES. INSTALL AS REQUIRED TO MEET ALL CONSTRUCTION CONDITIONS AND TO ALLOW FOR INSTALLATION OF OTHER WORK INCLUING DUCTS AND ELECTRICAL CONDUIT. AT ALL CONNECTIONS BETWEEN FERROUS PIPING AND NOMEROUS PIPING. PROVIDE AN ISOCIATING DIFLECTRIC UNION.
- PROVIDE ALL FITTINGS, ACCESSORIES, OFFSETS AND MATERIALS NECESSARY TO FACILITATE THE PLUMBING SYSTEMS FUNCTIONING AS INDICATED BY THE DESIGN AND THE EQUIPMENT INDICATED.
- PIPING ROUTED IN EXTERIOR WALLS SHALL BE ROUTED ON THE INTERIOR SIDE OF BUILDING WALL INSULATION,
- 10, ACCESS PANELS SHALL BE PROVIDED WHERE CONCEALED CONTROL
 DEVICES, VALVES, CLEANOUTS, ETC. ARE CONCEALED WITHIN CEILINGS AND
 WALLS. WHERE ACCESS FOR ADJUSTMENT AND MAINTENANCE IS POSSIBLE
 THRU LAYJN SUSPENDED CEILINGS. ACCESS PANELS ARE NOT REQUIRED.

11. THOROUGHLY CLEAN ITEMS BEFORE INSTALLATION, CAP PIPE OPENINGS TO EXCLUDE DIET NUTH, ENTURES ARE INSTALLED AND FINAL CONNECTIONS HAVE BEEN MADE. SET FIXTURES LEVEL AND IN PROPER ALIGNMENT, INSTALL SUPPLIES IN PROPER ALIGNMENT WITH FIXTURES, INSTALL SILCONE SEALANT BETWEEN FIXTURES AND ADJACENT MATERIAL FOR SANITARY CINEY.

DOMESTIC WATER PIPING

- PROVIDE PRESSURE REDUCING VALVE ON PLUMBING SYSTEMS WHERE THE INCOMING WATER SERVICE PRESSURE IS IN EXCESS OF 80 PSI.
- 2. HOT AND COLD WATER PIPING SHALL BE PEX TUBING, PROVIDE WATER HAMMER ARRESTORS PER DRAWINGS.
- 3. PROVIDE ISOLATION VALVES FOR EACH BRANCH OFF MAIN SUPPLY.
- SHUT-OFF VALVES WITH UNIONS SHALL BE PROVIDED FOR SERVICE TO EACH PLUMBING FIXTURE OR OTHER EQUIPMENT ITEM TO FACILITATE ISOLATION FOR REPAIR OR REPLACEMENT.
- 5. VALVE LOCATION TAGS REQUIRED ON ALL SHUT-OFFS AND LOCATION CHART REQUIRED.
- 6. THE DOMESTIC WATER SYSTEM SHALL BE FLUSHED, PRESSURE TESTED AND PURIHED, TEST WATER UNDER 80-100 FSIG HYDOSTATIC PRESSURE FOR 15 MINUTES MINIMUM. WHEN TESTING MOICATES MATERIALS OR WORKMANSHIP IS DEFICIENT, REPLACE OR REPAIR AS REQUIRED, AND REPEAT UNTIL. STANDARDS ARE ACHIEVED. ALL PIPING SYSTEMS SHALL BE SUBJECTED TO A DISINFECTION PROCEDURE PER THE RULES AND REGULATIONS OF THE ICCAL AUTHORPTIES.

SANITARY SEWER, STORM SEWER, AND VENT PIPING

- ALL OPENINGS IN DRAINAGE AND/OR VENT SYSTEMS AS A RESULT OF DEMOLITION OR INSTALLATION ROUGH-IN SHALL BE PROTECTED WITH A TEST PLUG THAT IS SECURELY LOCKED IN PLACE UNTIL FINAL FINISHED CONNECTIONS ARE INSTALLED.
- 2. PROVIDE A COMPLETE SYSTEM OF PVC VENT PIPING WITH AIR ADMITTANCE
- 3. CONDENSATE AND INDIRECT DRAIN PIPING SHALL BE TYPE PVC UP TO 1" ID.
- 4. DRAINAGE PIPING UNDERGROUND AND OUTSIDE THE BUILDING SHALL BE PVC PIPE AND FITTINGS. (ALTERNATE MATERIALS MAY BE ALLOWED IF APPROVED BY LOCAL CODE AUTHORITIES.)
- DRAINAGE PIPING INSIDE THE BUILDING SHALL BE PVC PIPE AND FITTINGS WITH SCHEDULE 40 PVC VENTS TO AIR ADMITTANCE VALVES.

6. PROVIDE CLEANOUTS AS SHOWN ON FLOOR PLAN AND ISOMETRIC ON DRAWING P2.0

- ALL DRAINAGE PIPING SHALL BE UNIFORMLY PITCHED, 1/4* PER FOOT UNLESS OTHERWISE REQUIRED BY EXISTING CONDITIONS, MINIMUM SLOPE SHALL BE PER CODE.
- 8. ALL FLOOR DRAINS SHALL BE CONNECTED TO THE SANITARY SEWER SYSTEM.
- 9. THE DRAINAGE SYSTEMS SHALL BE FLUSHED AND PRESSURE TESTED.

SUBSTITUTIONS

 THE NAMING OF MANUFACTURER'S IN THE SPECIFICATIONS SHALL NOT BE CONSTRUED AS ELIMINATING THE MATERIALS, PRODUCTS OR SERVICES OF OTHER MANUFACTURER'S AND SUPPLIERS HAVING EQUIVALENT ITEMS, ANY SUBSTITUTED ITEMS MUST BE EQUAL TO THOSE SPECIFIED, PROVIDE COST SAVINGS AND BE AVAILABLE TO MEET THE CONSTRUCTION SCHEDULE.

| P | LUMBING SYMBOLS |
|-------------------|---|
| — cws — | COLD WATER SUPPLY PIPING |
| — HWS — | HOT WATER SUPPLY PIPING |
| — SAN — | SANITARY WASTE PIPING |
| v | SANITARY VENT PIPING |
| | COLD WATER SUPPLY PIPING |
| | HOT WATER SUPPLY PIPING |
| | SANITARY VENT PIPING |
| BFP | BACKFLOW PREVENTER |
| со | CLEANOUT |
| CP | CHROME PLATED |
| DN | DOWN |
| DW | DISHWASHER |
| ET | EXPANSION TANK |
| FD | FLOOR DRAIN |
| GALV | GALVANIZED |
| INV. EL. | INVERT ELEVATION |
| IM | ICE MAKER |
| LAV | LAVATORY |
| NC | NEW CONNECTION |
| PRV | PRESSURE REDUCING VALVE |
| PSIG | POUNDS PER SQUARE INCH |
| S | SANITARY |
| SHR | SHOWER |
| SK | SINK |
| TMV | THERMOSTATIC MIXING VALVE |
| v | VENT |
| VTR | VENT THRU ROOF |
| w | WASTE |
| wc | WATER CLOSET |
| WH | WATER HEATER |
| \longrightarrow | LINE SIZE BALL GATE VALVE |
| <u>~~~</u> | LINE SIZE BALANCING VALVE |
| —ф— | LINE SIZE BALL VALVE (2" & SMALLER) OR LINE SIZE BUTTERFLY VALVE (2-1/2" & LARGER) |
| N | LINE SIZE CHECK VALVE |
| | LINE SIZE UNION |
| _\$_ | PRESSURE REDUCING VALVE |
| ħ | PRESSURE RELIEF VALVE |
| → | REDUCER |
| Į | THERMOMETER |
| | |

| 8/17/23 | 1 | PLAN REVIEW COMMENTS |
|---------|---|-----------------------|
| 9/13/23 | 2 | OWNER CLARIFICATIONS |
| 10/6/23 | 3 | PLAN REVIEW REVISIONS |
| | | |

PROFESSIONAL SEAL

DATE: REV: DESCRIPTION:

SHEET SCALE: 1:3
CREATED BY: MT
RELEASE DATE: 6/9/2023

FET FORMAT


MODEL: 2 DOOR CASITA (ARIZONA) BOXABL INC.
5345 EAST NORTH BELT ROAD
NORTH LAS VEGAS, NV 89115, USA

MODEL #: BXB-000009 +1(702) 500-9000 HELLO@BOXABL.COM

SHEET: P1.0

PROPRIETARY AND CONFIDENTIAL
THE INFORMATION CONTAINED IN THIS DRAWING IS THE
SOLE PROPERTY OF BOXABLINC, ANY REPRODUCTION IN
PART OR AS A WHOLE WITHOUT THE WRITTEN PERMISSIO
OF BOXABLINC, IS PROHIBITED.



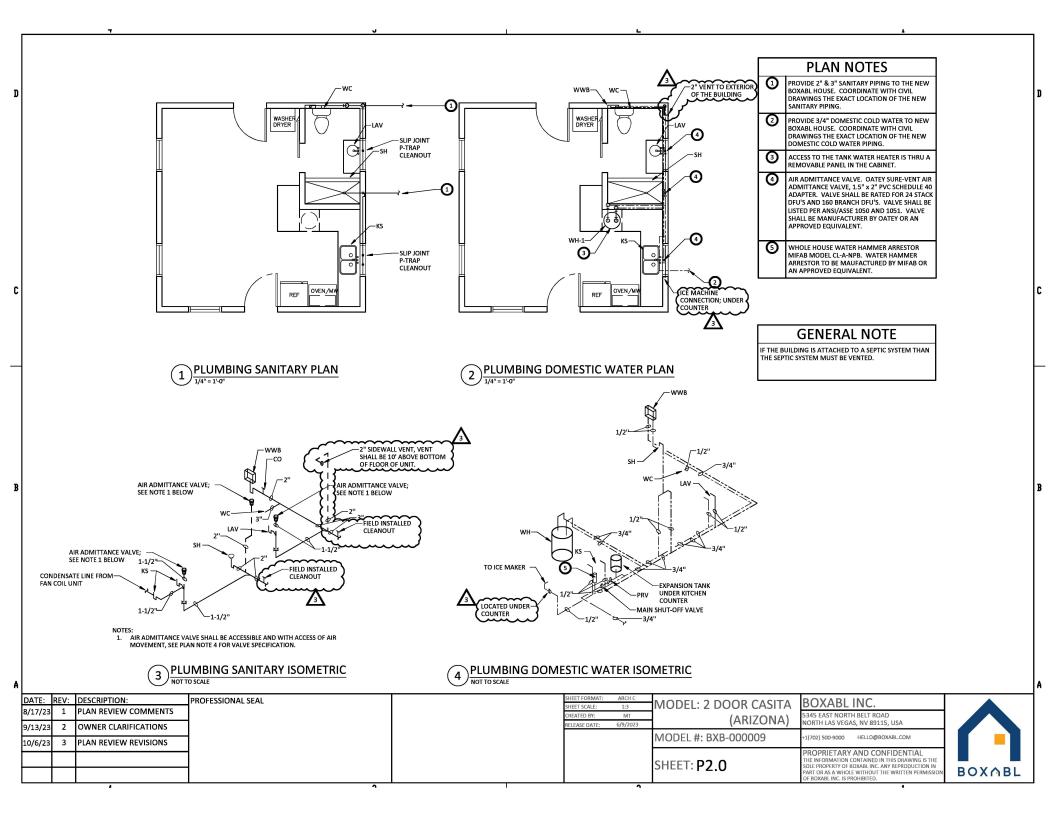


| | | | | FIXT | TURE SO | CHEDUL | .ES | | | | | | | |
|--------------|--|---------------|----------------|----------------|-----------|--------|----------------|------|--|--|--|--|--|--|
| FIXTURE | | | | | | | | | | | | | | |
| wc | WC WATER CLOSET SANIFLO 083 & 005 WHITE N/A INTERGRAL P-TRAP N/A 3/8" 1.28 GALLONS/FLUSH | | | | | | | | | | | | | |
| LAV | LAV LAVATORY BEELEE BL6790BH MATTE BLACK 1.2 GPM N/A MATTE BLACK 3/8" | | | | | | | | | | | | | |
| KS | KITCHEN FAUCET | MOEN | 5925BL | MATTE BLACK | 1.5 GPM | N/A | MATTE BLACK | 3/8" | | | | | | |
| SH | SHOWER | MOEN | T2472EPBL | MATTE BLACK | 1.75 GPM | N/A | MATTE BLACK | 1/2" | | | | | | |
| WWB-1 | WWB-1 WASHER WALL BOX SIOUX CHIEF 688-G10 WHITE N/A N/A N/A 2 @1/2" | | | | | | | | | | | | | |
| NOTE: FIXTUR | ES TO BE PROVIDE BY MAN | IUFACTURER AS | SCHEDULED OR A | N APPROVED EQU | JIVALENT. | | | | | | | | | |

| | WATER HEATER SCHEDULE | | | | | | | | | | | | |
|-----------|--|--|--|--|--|--|--|--|--|--|--|--|--|
| DESIG'N. | DESIG'N. TYPE MFG'R. MODEL NO. GAPACITY KW VOLTAGE PHASE AT 80°F RISE TANK LINING WARRANTY REMARKS | | | | | | | | | | | | |
| WH-1 | WH-1 TANK A.O. SMITH ENLB-30 30 4.5 240 SINGLE 23 YES YES | | | | | | | | | | | | |
| NOTE: WAT | NOTE: WATER HEATER TO BE MANUFACTURED BY A.O. SMITH OR AN APPROVED EQUAL. | | | | | | | | | | | | |

| | | | W | ATER SUPPLY F | IXTURE UN | IITS | | | | |
|----------|-------------|------------------------|-----------|---------------------------|-------------------------------|---------------|------------------|---------------------------------------|------------------|---------------|
| Quantity | Fixture Tag | Fixture | Occupancy | Type of Supply Control | Load Values (wsfu) Cold | in water supp | ly fixture units | Total Load Va units (wsfu) Cold | lues in water so | upply fixture |
| | 1 DW | Dishwashing machine | Private | Automatic | 0.00 | | | | | |
| | 1 IM | Ice Macine | Private | 3/8" valve | 0.25 | 0.00 | 0.25 | 0.25 | 0.00 | 0.25 |
| | 1 KS | Kitchen sink | Private | Faucet | 1.00 | 1.00 | 1.40 | 1.00 | 1.00 | 1.40 |
| | 1 LAV | Lavatory | Private | Faucet | 0.50 | 0.50 | 0.70 | 0.50 | 0.50 | 0.70 |
| | 1 SH | Shower head | Private | Mixing valve | 1.00 | 1.00 | 1.40 | 1.00 | 1.00 | 1.40 |
| | 1 WM | Washing machine (8 lb) | Private | Automatic | 1.00 | 1.00 | 1.40 | 1.00 | 1.00 | 1.40 |
| | 1 WC | Water closet | Private | Flush tank | 2.20 | 0.00 | 2.20 | 2.20 | 0.00 | 2.20 |
| | | | | Total WSFU | | | | 5.95 | 4.90 | 8.75 |

| | DRAINAGE FIXTURE UNITS | | | | | | | | | | | |
|----------|------------------------|--|--|----------------------------------|--|--|--|--|--|--|--|--|
| Quantity | Eistum Ton | Fixture Type | Drainage Fixture Unit Value As Load Factors | Minimum Size of Trap (inches) | Total Drainage Fixture Unit Value As Load Factors | | | | | | | |
| _ | | | | | | | | | | | | |
| 1 | WM | Automatic clothes washers, residential | 2.00 | 2.00 | 2.00 | | | | | | | |
| 1 | DW | Dishwashing machine, domestic | 2.00 | 1.50 | 2.00 | | | | | | | |
| 1 | KS | Kitchen sink, domestic | 2.00 | 1.50 | 2.00 | | | | | | | |
| 1 | LAV | Lavatory | 1.00 | 1.25 | 1.00 | | | | | | | |
| 1 | SH1 | Shower Flow Rate 5.7 gpm or less | 2.00 | 1.50 | 2.00 | | | | | | | |
| 1 | WC | Water closet, private (1.6 gpf) | 3.00 | | 3.00 | | | | | | | |
| | | | | | | | | | | | | |
| | | Total DFU's | | | 12.00 | | | | | | | |

THREDAIR ADMITTANCE VALVES (AAV) ARE BEING PROVIDED FOR THE BUILDING, EACH AAV IS RATED FOR 24 DFD'S WHICH WILL SATISFY THE TOTAL BUILDING LOAD OF 12 DFU'S.

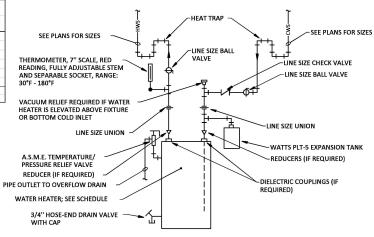

DOMESTIC WATER HEATER PIPING DETAIL - ELECTRIC NOTTO SCALE

| DATE: | | | PROFESSIONAL SEAL | | SHEET FORMAT: SHEET SCALE: | ARCH C | MODEL: 2 DOOR CASITA | BOXABL INC. |
|---------|---|-----------------------|-------------------|---|-------------------------------|----------|----------------------|--|
| 8/17/23 | 1 | PLAN REVIEW COMMENTS | | | CREATED BY: | MT | (ADIZONA) | 5345 EAST NORTH BELT ROAD |
| 9/13/23 | 2 | OWNER CLARIFICATIONS | | F | RELEASE DATE: | 6/9/2023 | , | NORTH LAS VEGAS, NV 89115, USA |
| 10/6/23 | 3 | PLAN REVIEW REVISIONS | 1 | | | | MODEL #: BXB-000009 | +1(702) 500-9000 HELLO@BOXABL.COM |
| | | | | | | | SHEET: P3.0 | PROPRIETARY AND CONFIDENTIAL THE INFORMATION CONTAINED IN THIS DRAWING IS THE SOLE PROPERTY OF BOXABL INC. ANY REPRODUCTION IN PART OR AS A WHOLE WITHOUT THE WRITTEN PERMISSION |
| | | | | | | | | OF BOXABLING, IS PROHIBITED. |

3 2

ELECTRICAL SPECIFICATIONS:

E1. A QUALIFIED ELECTRICIAN SHALL FURNISH AND INSTALL ALL LABOR, TOOLS, MATERIAL, EQUIPMENT, SERVICES, AND RELATED ACCESSORIES NECESSARY FOR THE COMPLETE INSTALLATION OF ELECTRICAL WORK SHOWN ON THE DRAWINGS, SPECIFIED IN THE NOTES, AND REQUIRED BY LOCAL CODE AUTHORITIES.

- E2. ALL WORK SHALL COMPLY WITH THE 2017 NEC AND 2018 INTERNATIONAL RESIDENTIAL CODE.
- E3. OBTAIN AND PAY FOR ALL PERMITS AND FEES RELATING TO ELECTRICAL SYSTEM.
- E4. IT IS INTENDED THAT ALL ITEMS OF WORK AND SYSTEMS BE COMPLETE AND WIRED COMPLETE IN ALL DETAILS, READY FOR SATISFACTORY OPERATION AND SERVICE. APPARATIS REQUIRED SHALL BE FURNISHED, EVEN THOUGH NOT SPECIFICALLY MENTIONED HEREIN, OR SHOWN ON THE DESTRUCTION.
- E5. PROVIDE GROUNDING OF ELECTRICAL WORK IN STRICT ACCORDANCE WITH THE APPLICABLE CODES AND THEIR AUTHORITIES.
- E6. COORDINATE ALL WORK WITH OTHER TRADES PRIOR TO ANY INSTALLATION.
- E7. PROVIDE CODE APPROVED CLEARANCES AROUND ELECTRICAL EQUIPMENT.
- E8. MATERIALS AND EQUIPMENT SHALL BE NEW AND SHALL CONFORM TO THE NEMA STANDARDS, NATIONAL ELECTRICAL CODE (NEC) IN EVERY CASE, WHERE SUCH STANDARDS HAVE BEEN ESTABLISHED. ALL ELECTRICAL MATERIALS, DEVICES, APPLIANCES, FITTINGS AND OTHER EQUIPMENT SHALL BE LISTED AND LABELED BY A QUALIFIED TESTING AGENCY AND SHALL BE CONNECTED IN AN APPROVED MANNER WHEN INSTALLED.
- E9. TESTING AFTER WIRES ARE IN PLACE AND CONNECTED TO DEVICES AND EQUIPMENT, THE SYSTEM SHALL BE TESTED FOR SHORTS AND GROUNDS. ALL HOT WIRES, IF SHORTED OR GROUNDED, SHALL BE REMOVED AND REPLACED.
- E10. ALL METERS, INSTRUMENTS, CABLE CONNECTION, EQUIPMENT, OR APPARATUS NECESSARY FOR MAKING ALL TESTS, SHALL BE FURNISHED BY THIS CONTRACTOR AT HIS OWN EXPENSE.
- E11. AFTER THE COMPLETION OF THE INSTALLATION, THE ENTIRE SYSTEM SHALL BE THOROUGHLY CLEANED. CLEAN ALL FOREIGN MATTER, PAINT, OIL, DIRT, UNREQUIRED LABELS, GRASE, AND STICKERS FROM FIXTURES AND EQUIPMENT. REMOVE FROM THE PREMISES ALL RUBBISH, DEBRIS, ETC. ACCUMULATED BY THE ELECTRICAL INSTALLATION.
- E12. THE CONTRACTOR SHALL BE RESPONSIBLE FOR PROTECTING ALL EQUIPMENT AND SYSTEMS AGAINST HARMFUL EXPOSURE, OR ACCUMULATION OF DUST/MOISTURE, FLOODING, CORROSION, OR OTHER FORMS OF DAMAGE. CLEAN AND RESTORE DAMAGED FINISHES AND EQUIPMENT TO PLACE INSTALLATION IN A LIKE-NEW CONDITION.
- E13. UNLESS SPECIFICALLY NOTED OTHERWISE, ALL INTERIOR WIRING SHALL BE NM-B CABLE.
 ELECTRICIAN SHALL PROVIDE EXTENSION OF ALL CABLE FROM JUNCTION BOX TO ELECTRICAL
 PANEL. PROVIDE CODE COMPUANT RACEWAY AND WIRING FROM INTERIOR JUNCTION BOX TO
 EXTERIOR PANEL. SEAL OPENING WEATHERTIGHT. PROVIDE INTERCONNECTION OF CABLES
 BETWEEN THE WALLS AND ROOF PANELS. THERE MAY BE SEVERAL CIRCUITS IN EACH PANEL.
 EACH IS LABELED WITH CIRCUIT NAME, CONNECT CIRCUITS OF LIKE NAMES.
- E14. DISCONNECT SWITCHES SHALL BE QUICK-MAKE, QUICK-BREAK TYPE IN NEMA ENCLOSURE TO MATCH LOCATION AND USE. SWITCHES SHALL BE LISTED FOR THEIR USE.
- E15. PANEL/LOAD CENTER SHALL BE AS SHOWN ON THE DRAWINGS WITH 100A-2P MAIN BREAKER AND BRANCH BREAKERS AS SCHEDULED. UNIT IS PROVIDED IN A NEMA 3R ENCLOSURE FOR EXTERIOR MOUNTING. INSTALL IN ACCORDANCE WITH MANUFACTURER'S INSTRUCTIONS. INSTALL BREAKERS AS REQUIRED. PANEL/LOAD CENTERS SHALL BE SQUARED QO SEREIS WITH QO BREAKERS OF RATON, SEIMENS OR GENERAL ELECTRIC EQUIVALENT. TERMINATE ALL CABLING AND WIRING AT PANEL/LOAD CENTER IN ACCORDANCE WITH NER CRQUIREMENTS.
- E16. INSTALL COMBINATION WASHER/DRYER BACKBOX WIRING AND PLUG IN WALL.
- E17. ASSEMBLE AND INSTALL PENDANT LIGHT FURNISHED WITH UNIT. PENDANT LIGHT SHALL BE LISTED PER 410.10(D).
- E18. INSTALL SMOKE DETECTOR FURNISHED WITH UNIT.
- E19. ASSEMBLE AND INSTALL EXTERIOR SCONCE LIGHT FURNISHED WITH UNIT BY FRONT DOOR. SEAL LIGHT TO EXTERIOR WALL TO BE WEATHER TIGHT.
- E19. ASSEMBLE AND INSTALL EXTERIOR SCONCE LIGHT FURNISHED WITH UNIT BY FRONT DOOR. SEAL LIGHT TO EXTERIOR WALL TO BE WEATHER TIGHT.
- E20. ALL EQUIPMENT LOCATED OUTDOORS SHALL BE WEATHERPROOF TYPE.

- E21. FURNISH AND INSTALL A COMPLETE AND OPERABLE SYSTEM OF SERVICE AND DISTRIBUTION FROM THE UTILITY COMPANY TRANSFORMERS OR FROM FEED FROM ANOTHER STRUCTURE TO THE PANEL/LOAD CENTER AS REQUIRED. PROVIDE A 120/240V, 1H-, 3W. SERVICE OR FEEDER TO THE LOAD CENTER RATED AT 100 AMPERS. MINIMUM FEEDER SIZE TO THE HOUSE SHALL BE 3 # 1 AWG COPPER CONDUCTORS. COORDINATE FINAL GROUNDING WITH METHOD OF FEEDING. SUGGESTED SERVICE GROUNDING DETAIL IS FOR UTILITY FED BUILDING.
- E22. TWO SMALL APPLIANCE 20A BRANCH CIRCUITS HAVE BEEN PROVIDED PER NEC 210.11 (C)(1) SERVING ONLY ABOVE COUNTER RECEPTACLES.
- E23. LAUNDRY AREA 20A BRANCH CIRCUITS HAS BEEN PROVIDED PER NEC 210.11 (C)(2) SERVING ONLY LAUNDRY AREA.
- E24. INDIVIDUAL APPLIANCE BRANCH CIRCUITS HAVE BEEN PROVIDED SERVING DEDICATED APPLIANCES INCLUDING HEAT A/C UNIT, REFRIGERATOR, MICROWAVE AND ELECTRIC RANGE.
- E25. BATHROOM RECEPTACLE 20A BRANCH CIRCUIT HAS BEEN PROVIDED PER NEC 210.11 (C)(3) SERVING ONLY BATHROOM RECEPTACLES.
- 26. RECEPTACLE OUTLETS HAVE BEEN INSTALLED IN ACCORDANCE WITH NEC 210.52. ALL RECEPTACLE SHALL BE USED AND GROUNDED TYPE AND INSTALLED IN ACCORDANCE WITH NEC 406.4. ALL RECEPTACLES SHALL BE PROVIDED WITH AFCI PROTECTION. ALL 15A AND 20A KITCHEN, BATHROOM, LAUNDRY, AND OUTDOOR RECEPTACLES SHALL BE SOFT IN PIPE. ALL OUTDOOR RECEPTACLES SHALL BE STATE TYPE WITH WEATHERPROOF COVERS
- 27. PROVIDE GROUNDING AND BONDING SHALL BE PROVIDED PER NEC 250.
- FITTINGS AND CONNECTORS THAT ARE INTENDED TO BE CONCEALED AT THE TIME OF ASSEMBLY SHALL BE LISTED AND IDENTIFIED FOR THE INTERCONNECTION OF BUILDING COMPONENTS. SUCH FITTING SHALL BE EQUAL TO THE WIRING METHOD EMPLOYED IN INSULATION, TEMPERATURE RISE, AND FAULT-CURRENT WITHSTANDING AND SHALL BE CAPABLE OF ENDURING THE VIBRATION AND SHOCK OCCURRING IN TRANSPORT.
- E29. GROUNDING OF BOTH ELECTRICAL AND NON ELECTRICAL METAL PARTS SHALL BE THROUGH CONNECTION TO A GROUNDING BUS IN THE PAREL/LOAD CENTER AND SHALL BE CONNECTED THROUGH THE GREEN-COLORED INSULATED CONDUCTOR IN THE FEEDER WIRING TO THE GROUNDING BUS IN THE SERVICE ENTRANCE COUPMENT.
- 10. THE INSTALLATION OF THE SERVICE EQUIPMENT SHALL COMPLY WITH ARTICLE 230. MEANS SHALL BE PROVIDED FOR THE CONNECTION OF A GROUNDING ELECTRODE CONDUCTOR TO THE SERVICE EQUIPMENT AND ROUTING IT OUTSIDE THE STRUCTURE. BONDING AND GROUNDING OF THE SERVICE SHALL BE IN ACCORDANCE WITH ARTICLE 250. THE MANUFACTURER SHALL INCLUDE IN ITS WRITTEN INSTALLATION INSTRUCTIONS ONE METHOD OF GROUNDING THE SERVICE EQUIPMENT AT THE INSTALLATION SITE. THE INSTRUCTIONS SHALL CLEARLY STATE THAT OTHER METHODS OF GROUNDING ARE FOUND IN ARTICLE 250.

THE MINIMUM SIZE GROUNDING ELECTRODE CONDUCTOR SHALL BE # 8 AWG COPPER.


A WARNING LABEL SHALL BE MOUNTED ON OR ADJACENT TO THE SERVICE EQUIPMENT. THE LABEL SHALL STATE THE FOLLOWING:
"WARNING DO NOT PROVIDE ELECTRICAL POWER UNTIL THE GROUNDING ELECTRODE(S) IS INSTALLED AND CONNECTED (SEE INSTALLATION INSTRUCTIONS)."

WHERE THE SERVICE EQUIPMENT IS NOT INSTALLED IN OR ON THE UNIT, THE INSTALLATION SHALL COMPLY WITH THE OTHER PROVISIONS OF THE NEC.

NOTES:


- G1. CONTRACTOR SHALL OBTAIN APPROVAL FROM LOCAL CODE AUTHORITIES BEFORE INSTALLING GROUNDING.
- G2. CONCRETE ENCASED ELECTRODE ENCASED BY A MINIMUM OF 2" OF CONCRETE ON ALL SIDES LOCATED WITHIN AND NEAR THE BOTTOM OF A CONCRETE FOOTING OR FOUNDATION. ELECTRODE SHALL CONSIST OF A MINIMUM OF 20" OF BARE COPPER CONDUCTOR (# 4) WHERE APPLICABLE. (SEE NEC 250.52 (A) (3) (2))
- G3. BOND TO REBAR STUBOUT IN FOUNDATION PER NEC 250 WHERE APPLICABLE (SEE NEC 250.52 (A) (3) (1))


| SYMBOL | DESCRIPTION | | | | | |
|------------|---|--|--|--|--|--|
| | | | | | | |
| Ю,О | JUNCTION BOX - WALL OR CEILING MOUNTED | | | | | |
| 괍 | NON - FUSED DISCONNECT SWITCH | | | | | |
| 짣 | FUSED DISCONNECT SWITCH | | | | | |
| 9 | MOTOR CONNECTION - H.P. AS NOTED ON DRAWINGS | | | | | |
| * | NM-B CABLE RUN CONCEALED IN CEILING OR WALLS. | | | | | |
| | X DENOTES GROUND WIRE | | | | | |
| | DENOTES NEUTRAL CONDUCTOR DENOTES HOT CONDUCTOR | | | | | |
| | DENOTES HOT CONDUCTOR | | | | | |
| _ | LOAD CENTER | | | | | |
| ₽. | DUPLEX RECEPTACLE (NEMA 5-20R) (+18" AFF UNLESS NOTED OTHERWISE) | | | | | |
| ₩ | DUPLEX RECEPTACLE (NEMA 5-20R) (MOUNTED 6" ABOVE COUNTER TOP UNLESS NOTED OTHERWISE) | | | | | |
| ⊭ | DUPLEX CONVENIENCE OUTLET (NEMA 5-15R) | | | | | |
| Ю | SPECIAL OUTLET. REFER TO POWER PLAN ON SHEET E1.0 FOR REQUIREMENTS | | | | | |
| Ю | SINGLE NEMA 5-20R RECEPTACLE | | | | | |
| ® | CEILING MOUNTED COMINATION SMOKE/FIRE/CARBON MONOXIDE ALARM - USI ELECTRIC MUC1509S HARDWIRED ALARM WITH 10 YEAR SEALED BATTERY OR EQUAL. | | | | | |
| A . | DENOTES AMPERES | | | | | |
| A.C. | DENOTES ABOVE COUNTER | | | | | |
| A.F.F. | DENOTES ABOVE FINISHED FLOOR | | | | | |
| AFCI | DENOTES ARC FAULT CIRCUIT INTERRUPTER | | | | | |
| C. | DENOTES CONDUIT | | | | | |
| GFCI | DENOTES GROUND FAULT CIRCUIT INTERRUPTER | | | | | |
| GRD. | DENOTES GROUND | | | | | |
| M.L.O. | DENOTES MAIN LUGS ONLY | | | | | |
| WP | DENOTES WEATHERPROOF (NEMA 3R) | | | | | |

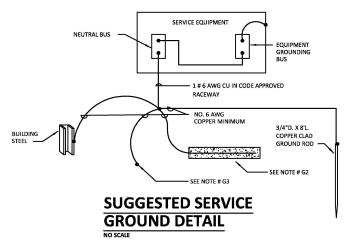

| | | | PROFESSIONAL SEAL | SHEET FORMAT: SHEET SCALE: | ARCH C 1:3 | MODEL: 2 DOOR CASITA | BOXABL INC. | |
|---------|---|-----------------------|-------------------|-------------------------------|---------------|----------------------|---|--------|
| 8/17/23 | 1 | PLAN REVIEW COMMENTS | | CREATED BY: | MT | | 5345 EAST NORTH BELT ROAD NORTH LAS VEGAS, NV 89115, USA | |
| 9/13/23 | 2 | OWNER CLARIFICATIONS | | RELEASE DATE: | 6/9/2023 | ` ' | | |
| 10/6/23 | 3 | PLAN REVIEW REVISIONS | | | | MODEL #: BXB-000009 | +1(702) 500-9000 HELLO@BOXABL.COM | |
| | | | | | | SHEET: E1.0 | PROPRIETARY AND CONFIDENTIAL THE INFORMATION CONTAINED IN THIS DRAWING IS THE SOLE PROPERTY OF BOXABLING, ANY REPRODUCTION IN | |
| | | | | | | | PART OR AS A WHOLE WITHOUT THE WRITTEN PERMISSION OF BOXABL INC. IS PROHIBITED. | BOX∧BL |

OUTDOOR WALL LAMP (FURNISHED WITH UNIT INSTALLED BY ELECTRICIAN POWER NOTES: LOAD CENTER FULLY ASSEMBLED AND INSTALLED IN FACTORY. 1 2 3 4" LED DOWNLIGHT. 1 (120V, 1PH, 11W) 2 ELECTRICIAN TO PROVIDE ELECTRICAL FEEDER/ELECTRICAL SERVICE FROM SITE TO 3 ELECTRICIAN TO PROVIDE SERVICE GROUND/BUILDING GROUND PER NEC VET LOCATION LISTED PER NEC 410.10(D). ELECTRICIAN TO WIRE OUTDOOR CONDENSER UNIT EXTEND WIRING AND INTERCONNECT WIRING FROM INDOOR FAN COIL PER MANUFACTURERS DIRECTIONS. COORDINATE INSTALLATION WITH MECHANICAL CONTRACTOR AS TO NOT IMPEDE CODE REQUIRED CLEARANCE FOR ELECTRICAL PANELS/SERVICE DISCONNECTS. PROVIDE COMBO BATH FAN/LIGHT SWITCH WITH VENTILATION CONTROL 5 PENDANT & DELAY TIMER. (LEGRAND RADIANT 4 BUTTON DIGITAL TIMER # RT2BKCCV4 OR FIXTURE (LISTED PER NEC 410.10(D)) 6 COMBINATION SMOKE/FIRE/CARBON MONOXIDE ALARM WITH BATTERY BACKUP. UNIVERSAL SECURITY INSTRUMENTS # MIC1509S HARDWIRED 3 IN 1 SMART ALARM WITH 10 YEAR SEALED BATTERY OR EQUAL. DETECTOR SHALL BE LOCATED MINIMUM OF 20 FEET FROM COOKING APPLIANCE. ⊚ ABOVE CARINET FOR ROUTER CIRCUIT PROTECTION NOTES: ③ ARC FAULT CIRCUIT INTERRUPTER PROTECTION SHALL BE PROVIDED FOR ALL 15 AND 20A BRANCH CIRCUITS SUPPLYING OUTLETS AND DEVICES IN ACCORDANCE OUTDOOR WALL LAMP (FURNISHED WITH UNIT LESS THAN 4' BETWEEN SINE GROUND FAULT CIRCUIT INTERRUPTER PROTECTION SHALL BE PROVIDED FOR INSTALLED BY ELECTRICIAN) ALL 15A AND 20A RECEPTACLES AND EQUIPMENT IN ACCORDANCE WITH NEC AND STOVE) **LIGHTING PLAN POWER PLAN** SCALE: 1/4"=1'-0" **EQUIPMENT SCHEDULE** CIRCUIT DATA **(#)** CONDUCTORS RECEPTACLE MARK EQUIPMENT DESCRIPTION TYPE QTY. SIZE EQ. GND VOLTAGE PHASE AMPS HEIGHT ELECTRICAL CALCULATIONS (NEC) WASHER DRYER 120 10.0 5-20R #12 #12 18" A.F.F. 1 A-10 2 WATER HEATER 18.75 240 6-30R A-(6.8) 2 # 10 #10 18" A.F.F. 1 40.0 18" A.F.F. 3 RANGE 240 14-50R* A-(2,4) 2 #6 #10 4 REFRIGERATOR 12 2 120 1 #12 5-20R A-1 #12 18" A.F.F. MICROWAVE 5 120 12 5-20R 1 A-3 2 #12 #12 84" A.F.F. Arizona Casita BXB-000009 WIRE TO 3 #14 FAN COIL UNIT FCU-1 1 1.0 240 CU-1 2 #12 EXHAUST FAN EF-1 120 #12 1 A-9f TOTAL AREA (SQ FT) 120/240V., 1PH., 3W. WATTS 8 OUTDOOR CONDENSER CU-1 240 1 15.0 A-(11,13) 2 #10 GENERAL LIGHTING LOAD CALC 361 X 1083 W GEN LTG/REC *14-50R IS A THREE PHASE RECEPTACLE ONLY TWO PHASES USED. COORDINATE PHASING. SMALL APPLIANCE PANEL DATA SCHEDULE SUBTOTAL 5583 PANEL NAME: DEMAND LOAD KVASURFACE DEMAND KEY: L: LIGHTING LOCATION OUTDOOR CONNECTED LOAD DEMAND LOAD SERVICE _____120/240V.,1PH,.3W. R: RECEPTACLES 1ST 20 KW 5583 5.583 __KVA 12.94 KVA 10.62 KVA PHASE A M: MOTORS KVA MAIN BREAKER 100A-2P WATER HEATER 4500 X 100% = 4.500 10.20 KVA PHASE B 12.45 KVA MAIN LUGS ONLY SHWASHED NEUTRAL BUS 100A GROUND BUS YES 0.00 T: TRANSFORMERS _KVA 20.82 KVA TOTAL E: EQUIPMENT S & X: SPARE & SPACE 100% = GROUND BUS TEST RATING 10.000 RMS SYM AMPS 105 AMPS 87 AMPS 8.4 SYAR NOTES: NEMA 3R - SERVICE ENTRANCE RATED - MINIMUM 0F 3 # 2 AWG SERVICE DESCRIPTION OF SERVICE ENTRANCE RATED - MINIMUM 0F 3 # 2 AWG SERVICE DESCRIPTION OF SERVICE ENTRANCE RATED - MINIMUM 0F 3 # 2 AWG SERVICE DESCRIPTION OF SERVICE SERVICE STATE OF SERVICE S _KVA MISC 100% FAN COIL 240 X CONNECTED LOA CONNECTED LOAD CIRCUIT USE CIRCUIT USE ELECTRIC DRYER 0 X 100% R: REFRIGERATOR 1.440 20A-1P AFGCI 50A-2P 4.800 RANGE ELECTRIC DANGE 9600 X 80% = 7 680 MICROWAVE 20A-1P AFGCI R: BATHROOM RECEPTACLE 2,250 M: WATER HEATER 360 ARGEST MOTOR 0 X 20A-1P AFGCI R: LIVING ROOM/EXTERIOR RECEPTS.
L: BATH/KITCHEN/LIVING ROOM LTS 192 1,260 20A-1P AFGC 2,250 TOTAL DEMAND: 20,403 WATTS 1,200 WASHER/DRYER 1,200 1,500 R: KITCHEN SMALL APPL.
R: DINING/KITCHEN SMALL APP M: CU-1/FCU-1 30A-2P VOLTAGE: 20 KW 1,200 1,500 X: BLANKSPACE BI ANKSPACE BLANKSPACE BLANKSPACE X: BLANKSPACE X: BLANKSPACE X: BLANKSPACE MINIMUM SERVICE SIZE: 85 AMPS BLANKSPACE BLANKSPACE X: BLANKSPACE SUB TOTAL 3,192 3,900 9,750 8,550 SERVICE SIZE: SHEET FORMAT ARCHC REV: DESCRIPTION: DATE: PROFESSIONAL SEAL BOXABL INC. MODEL: 2 DOOR CASITA HEET SCALE 8/17/23 1 PLAN REVIEW COMMENTS MT 5345 EAST NORTH BELT ROAD (ARIZONA) NORTH LAS VEGAS, NV 89115, USA 6/9/2023 9/13/23 2 OWNER CLARIFICATIONS FLEASE DATE: MODEL #: BXB-000009 1(702) 500-9000 HELLO@BOXABL.COM 10/6/23 3 PLAN REVIEW REVISIONS PROPRIETARY AND CONFIDENTIAL E2.0 THE INFORMATION CONTAINED IN THIS DRAWING IS THE SHEET: SOLE PROPERTY OF BOXABLING ANY REPRODUCTION IN BOXABL PART OR AS A WHOLE WITHOUT THE WRITTEN PERMISSION OF BOXABL INC. IS PROHIBITED.

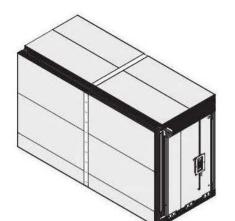

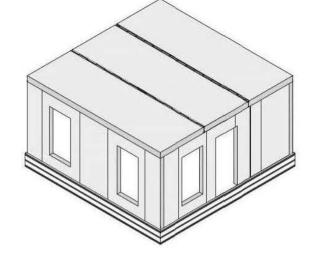



Studio Casita Model # BXB-000009

ARIZONA

PRELIMINARY STRUCTURAL DRAWINGS

FOR INFORMATION / MARKETING ONLY. NOT FOR SITE-SPECIFIC USE.

APPROXIMATE MAXIMUM ELEVATIONS TO STAY WITHIN **SNOW LOAD** CAPACITY:

ZONE 1: NONE

ZONE 2: 5,200 ft

ZONE 3: 5,800 ft

ZONE 4: 5,300 ft

ZONE 5: NONE

ZONE 6: NONE

ZONE 7: 6,300 ft



SUITABILITY RESTRICTIONS: MAX. ALLOWED ULTIMATE WIND SPEED:

115 mph, Exposure C

127 mph. Exposure B 104 mph, Exposure C (w/ ADDED ROOF TRUSSES) 115 mph, Exposure B (w/ ADDED ROOF TRUSSES)

WIND PRESSURE, qh = 12.1 psf (max.)

EXPOSURE B IS URBAN AND SUBURBAN AREAS, WOODED AREAS, OR OTHER TERRAIN w/ NUMEROUS, CLOSELY SPACED OBSTRUCTIONS THAT HAVE A SIZE OF A SINGLE-FAMILY DWELLING. THESE CONDITIONS PREVAIL IN THE UPWIND DIRECTION FOR A DISTANCE GREATER THAN 1,500 FT.

EXPOSURE C IS OPEN TERRAIN W/ SCATTERED OBSTRUCTIONS THAT HAVE HEIGHTS GENERALLY LESS THAN 30 FT. THIS INCLUDES FLAT, OPEN COUNTRY AND GRASSLANDS.

SEISMIC: NO RESTRICTIONS

MAX. ALLOWED GROUND SNOW LOAD, Pg = 41 psf (34 psf if located tight in among conifer trees)

(16 psf max, in Seismic Design Categories, D, E, F - reduced to 14 psf if located tight in among conifer trees)

MAX, ALLOWED ROOF SNOW LOAD, Pf = 29 psf (12 psf max. in Seismic Design Categories, D, E, F)

AFTERMARKET ROOF REQUIREMENTS: OPTIONS & LIMITATIONS:

MAXIMUM SLOPE OF AFTERMARKET PITCHED ROOF TRUSS ADD-ON: 5:12 MAXIMUM SLOPE OF AFTERMARKET MONOSLOPE ROOF TRUSS ADD-ON: 2:12. MAXIMUM ROOFING WT OVER TRUSSES: 16 psf

MAXIMUM TAPERED INSULATION WT: 2 psf

AFTERMARKET PRODUCTS DESIGNED & SUPPLIED BY OTHERS. SEE ARCHITECTURAL DRAWINGS FOR ADD'L INFO INCLUDING MINIMUM SLOPE SPECIAL INSPECTIONS:

SIP SHEARWALLS INSTALLED IN BUILDINGS IN IBC SEISMIC DESIGN CATEGORIES C, D, E AND F; OR SEISMIC DESIGN CATEGORIES DO, D1, D2 AND E FOR DETACHED ONE-AND TWO-FAMILY DWELLINGS UNDER THE IRC, PERIODIC INSPECTION OF THE FASTENING AND ANCHORING OF THE SHEAR WALL ASSEMBLY WITHIN THE SEISMIC-FORCE-RESISTING SYSTEM MUST BE PROVIDED. INSPECTION MUST INCLUDE CONNECTIONS OF THE ASSEMBLIES TO HOLDDOWNS, IN ACCORDANCE WITH 2021 IBO SECTION 1705.14 AND 2018 IBC SECTION 1705.12

| DATE: | REV: | DESCRIPTION: | PROPRIETARY AND CONFIDENTIAL |
|-------|------|--------------|---|
| | | | AS INSTRUMENTS OF SERVICE, SHESS DRAWNINGS SHAPE, BRAWN THE MODERNY OF SIP ENGENEEMED GOODS AND |
| | | | WRITTEN PERMISSION OF SIPERGREERING CONSECTIONS, LLC |

SIP Engineering Consultants, LLC

14712 SW Murray Scholls Dr. Beaverton, OR 97007 Mike@SIPconsultants.com Phone: 503-564-4178

| INITS: | FT-IN | MODEL: 2 DOOR CASITA |
|---------------|-----------|----------------------|
| HEET FORMAT: | ARCH C | THOUSE E DOON CHOITT |
| HEET SCALE: | NONE | |
| REATED BY: | MN | MODEL #: BXB-000009 |
| RELEASE DATE: | 11/3/2023 | |
| SHEET: C | 51 | ARIZONA |

BOXABL INC. 5345 EAST NORTH BELT ROAD NORTH LAS VEGAS, NV 89115, USA

+1(702) 500-9000 HELLO@BOXABL.COM



